

Florence County Government

Procurement Department

July 21, 2016

ADDENDUM NO. 2 - FRIENDFIELD FIRE STATION (BID NO. 2-16/17)

Florence County is sending to all interested firms clarification information and answers to questions concerning this request for proposal. The answers are highlighted in blue and underlined. Please include this sheet with your proposal.

- 1. The Bid Documents state that a minimum Group 2 General Contractors license in the State of South Carolina is required to do this work. Per SCLLR, a Group 2 is only good to \$100,000. Should this be a Group 3 instead (good for up to \$350,000)? A minimum Group 3 license shall be required to qualify for this bid.
- 2. Is this a Normal or Essential building occupancy? This building is classified as Risk IV (Essential occupancy).
- 3. Is 26 ga liner panel allowed in lieu of 24 ga? Yes, 26 gauge is acceptable.
- 4. Is an expandable endwall required at column line 3 at A1.0? No, we will use a standard endwall.
- 5. On the riser diagram it shows (2)4-350KCMIL, 3-1/2"C, this is typical of a 600A 3 phase service. The disconnect transfer switch and panel A are all single phase 200 Amp. Can we get clarification as to if this is an error? Yes, this was an error, and it is corrected in the updated plans. The service is 200 Amp single phase.

We have attached a new set of Civil/Architectural drawings, which encompass comments from SCDOT, SCDHEC and Florence County. The revisions are clouded. A summary follows:

Sheet A3.0 The elevations of the exterior lights are shown.

This includes light OB for the flagpole illumination.

Light OB for the sign was switched from a ground to a wall mount.

Sheet A4.0 The colors are specified for walls and doors.

City-County Complex

Sheet A6.0	The insulation on the ceiling and walls above the liner panel will be
	4" R11 white vinyl-faced insulation.
Sheet C2.0	Added more gravel to allow the fire trucks to turn around without
	entering the road.
	Added striping, stop bar and stop sign (yes, a stop sign) to apron.
Sheet C3.0	The driveway culvert has been revised from a Class III 18" RCP to a
	Class V 15" RCP. Note the beveled ends per SCDOT specifications.
Sheet C8.0	NEW SHEET.
	Mostly DOT standard drawings, plus more info on the driveway pipe.
Sheet P1.0	Exterior hose bibb HB1 shall be keyless & frostless.
Sheet P2.0	Pex type cold water pipe is allowed below the slab.
	On hose bibs protruding from behind the metal wall liners, the shut-off
	valve is set above the liner for easier access.
Sheet M1.0	On the Fan Schedule, Fan-3 (the bathroom exhaust fan) will be keyed into
	the light switch (not Fans 1 & 2).
Sheet M2.0	To avoid a conflict with the overhead doors, IFH-1 was shifted.
	The gas line was extended; the control box is on the north side of the IFH.
Sheet M3.0	Added minimum clearances for the IFH-1 unit.
Sheet E1.0	Added missing information for the wall heaters, EWH-1 and EWH-2.
Sheet E2.0	Lights HB-1 will be surface mounted to avoid conflicts with IFH-1 and
	the overhead doors.
	The OB lights will have different mounts:
	The flagpole light will be ground mounted.
	The sign light will be wall mounted.
	BX Cabling is allowed as an alternate to conduit.
Sheet E3.0	Corrected the service lines per Item 5 above.
Sheet E4.0	Moved the junction box on IFH-1 to the front of the building.
	Shifted HB-1 lights to avoid conflicts with IFH-1 & the overhead doors.
	Added locations of the OB lights (outdoor spotlights).

I have read and acknowledge pages 1, 2, and 3 of addendum no. 2 for bid no. 02-16/17. Authorized Signature Printed Name Date Company Name

YOU MUST ACKNOWLEDGE THIS ADDENDUM BY SIGNING BELOW AND SUBMIT IT

CONSTRUCTION PLANS

FOR:

HANNAH-SALEM-FRIENDFIELD FIRE DEPARTMENT NEW STATION AT FRIENDFIELD

Capital Project Sales Tax II Florence County, South Carolina

PROJECT No. AE055

April, 2016

WATER WILL BE FROM WELL ON SITE.

SEWER WILL BE TREATED USING A DHEC DESIGNED SEPTIC SYS

FIRE STATION & PARKING LOT WITH ACCESS TO HYMAN ROAD.


Client:


FLORENCE COUNTY 180 NORTH IRBY STREET, MSC-G FLORENCE, SOUTH CAROLINA 29501

FLORENCE COUNTY CONTACT: SUZANNE KING
PHONE: (843) 665-3035
FIRE DEPARTMENT CONTACT: CHIEF MONTY TEDDER
PHONE: (843) 319-8083

INDEX TO DRAWINGS:

SERIES NUMB	ERING										
CS	Λ	COVER SHEET	CIVIL			PLUMBING			ELECTRICAL	۸	
ARCHITECTUF	AL		C1.0		EXISTING SITE CONDITIONS	P1.0	\triangle	PLUMBING NOTES	E1.0	\	ELECTRICAL NOTES
A1.0		FLOOR PLAN & NOTES	C2.0		SITE DEVELOPMENT PLAN	P2.0	Λ	PLUMBING PLANS	E2.0	4	ELECTRICAL NOTES & SCHEDULES
A2.0	Λ	REFLECTIVE CEILING & ROOF PLAN	C3.0	Λ	GRADING & DRAINAGE PLAN	P3.0	Value	PLUMBING DETAILS	E3.0	4	ELECTRICAL DETAILS
A3.0	$\overline{\Lambda}$	ELEVATIONS	C4.0		SEDIMENT & EROSION CONTROL PLAN				E4.0	<u></u>	ELECTRICAL PLANS
A4.0	$\overline{\Lambda}$	DETAILS & SCHEDULES	C5.0		WATER & SEWER PLAN	MECHANICAL	^				
A5.0		SECTIONS	C6.0		SITE DEVELOPMENT DETAILS	M1.0	Δ	MECHANICAL NOTES			
A6.0	Λ	WALL SECTIONS	C7.0		SEDIMENT & EROSION CONTROL DETAILS	M2.0	<u>_1</u>	MECHANICAL FLOOR PLANS			
	<u> </u>					M3.0	Λ	MECHANICAL DETAILS			

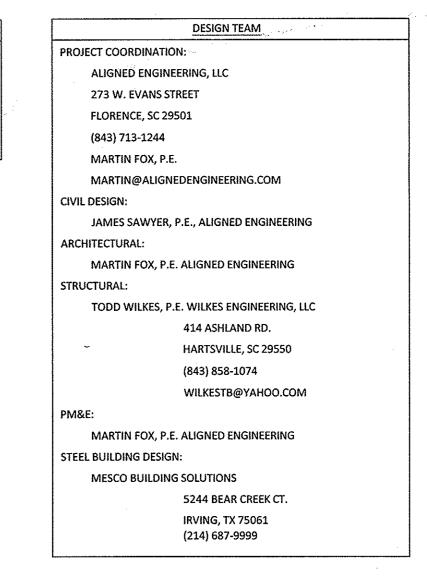

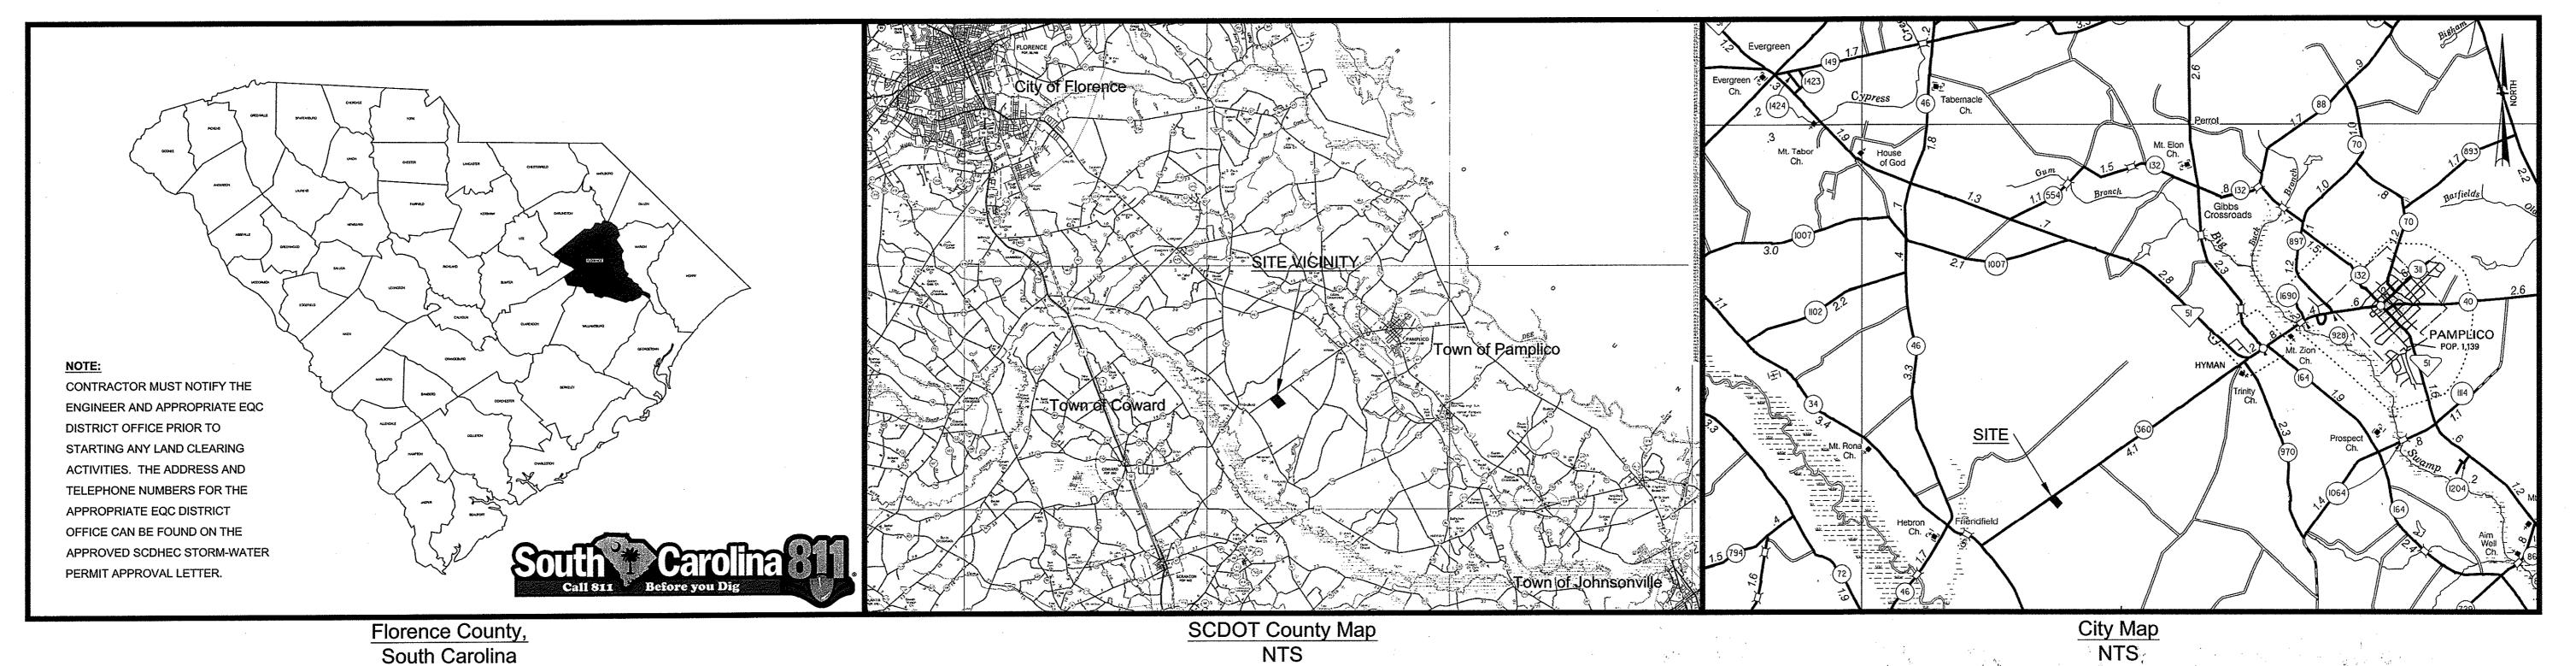


| DESIGNED BY: MJF | DESIGNED BY: MJF | DESIGNED BY: JCS | CHECKED BY: MJF | MJF | DATE: Jul 21, 2016 | CHECKED BY: MJF | DATE: Jul 21, 2016 | CHECKED BY: MJF | DATE: Jul 21, 2016 | CHECKED BY: MJF | DATE: Jul 21, 2016 | CHECKED BY: MJF | DATE: Jul 21, 2016 | CHECKED BY: MJF | CHEC


COVER SHEET

DESIGN

AE05

Jul 21, 2016

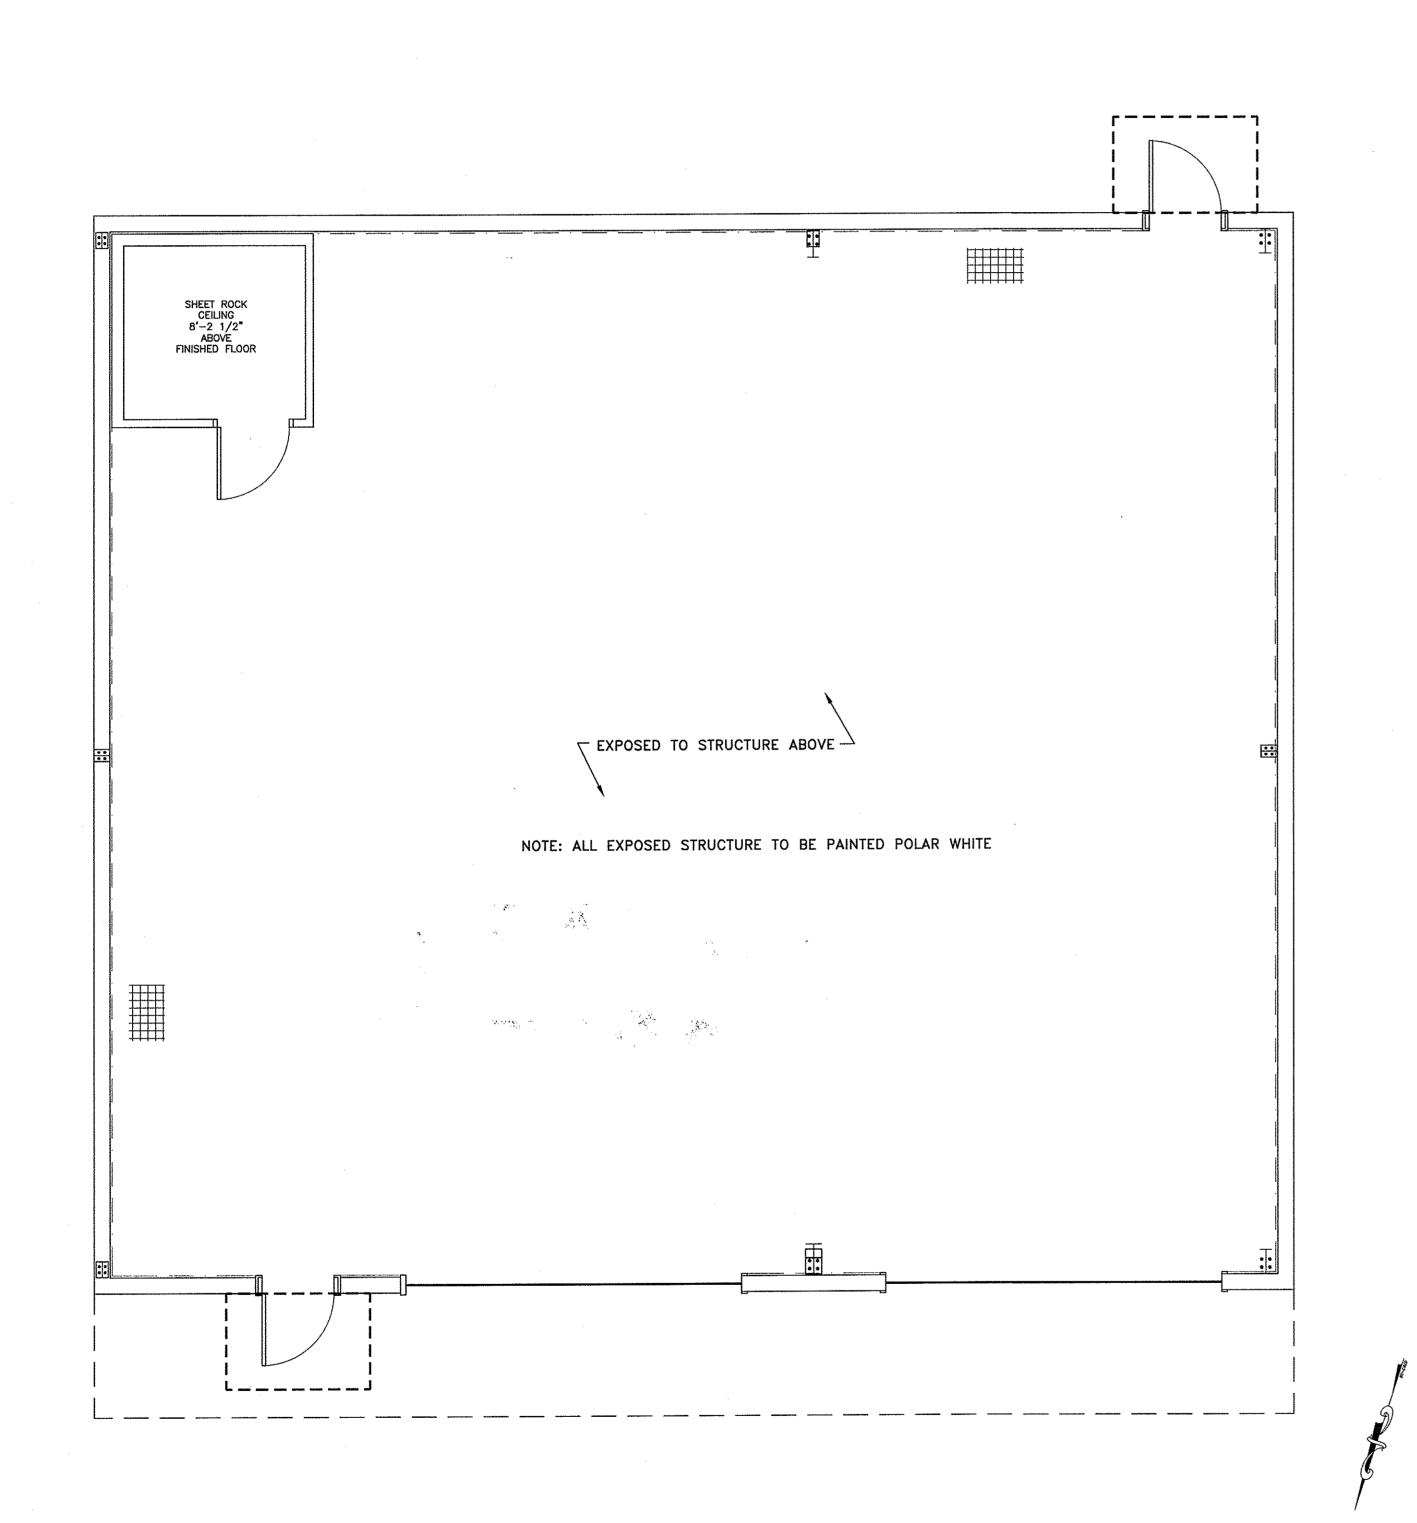

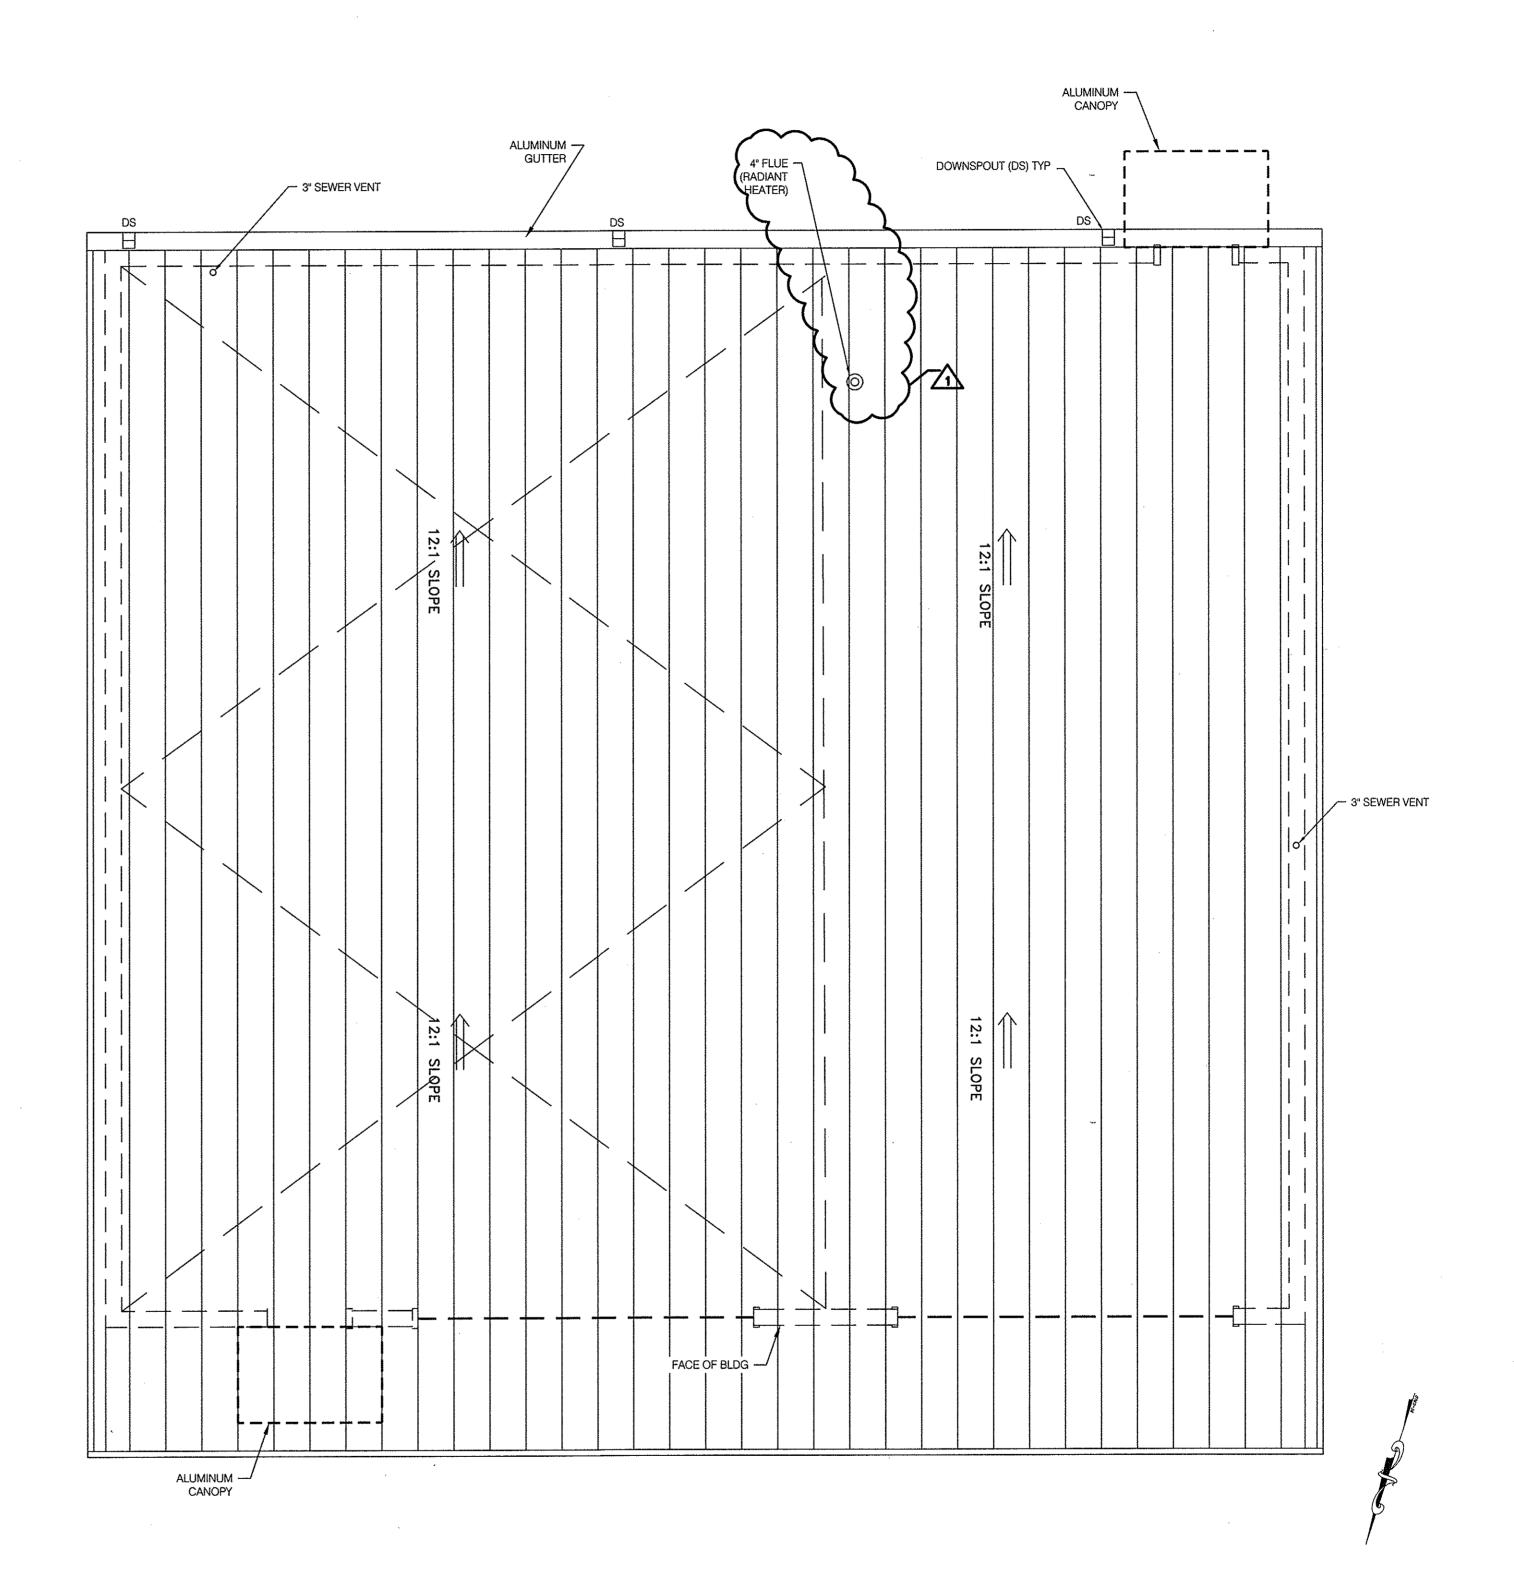

REFLECTED CEILING PLAN
SCALE: 1/4"=1'-0"

ROOF PLAN
SCALE: 1/4"=1'-0"

3CALE 4' 2' 0 2' 4' 6' 8 1/4"=1'-0" REFLEC.CEILING
& ROOF PLAN

PLAN SET: DESIGN

DATE: Jul 21, 2016

PROJECT: AE055


SHEET: A2.0


ALIGNED ENGINEERING No. 5025


ALUGNED
ENGINEENING
THEREON ARE THE PROPERTY OF AL


NEW STATION AT FRIENDFIELD REFLEC. CELING & ROOF PLAN


HANNAH-SALEM FRIENDFIELD FIRE DEPARTMENT

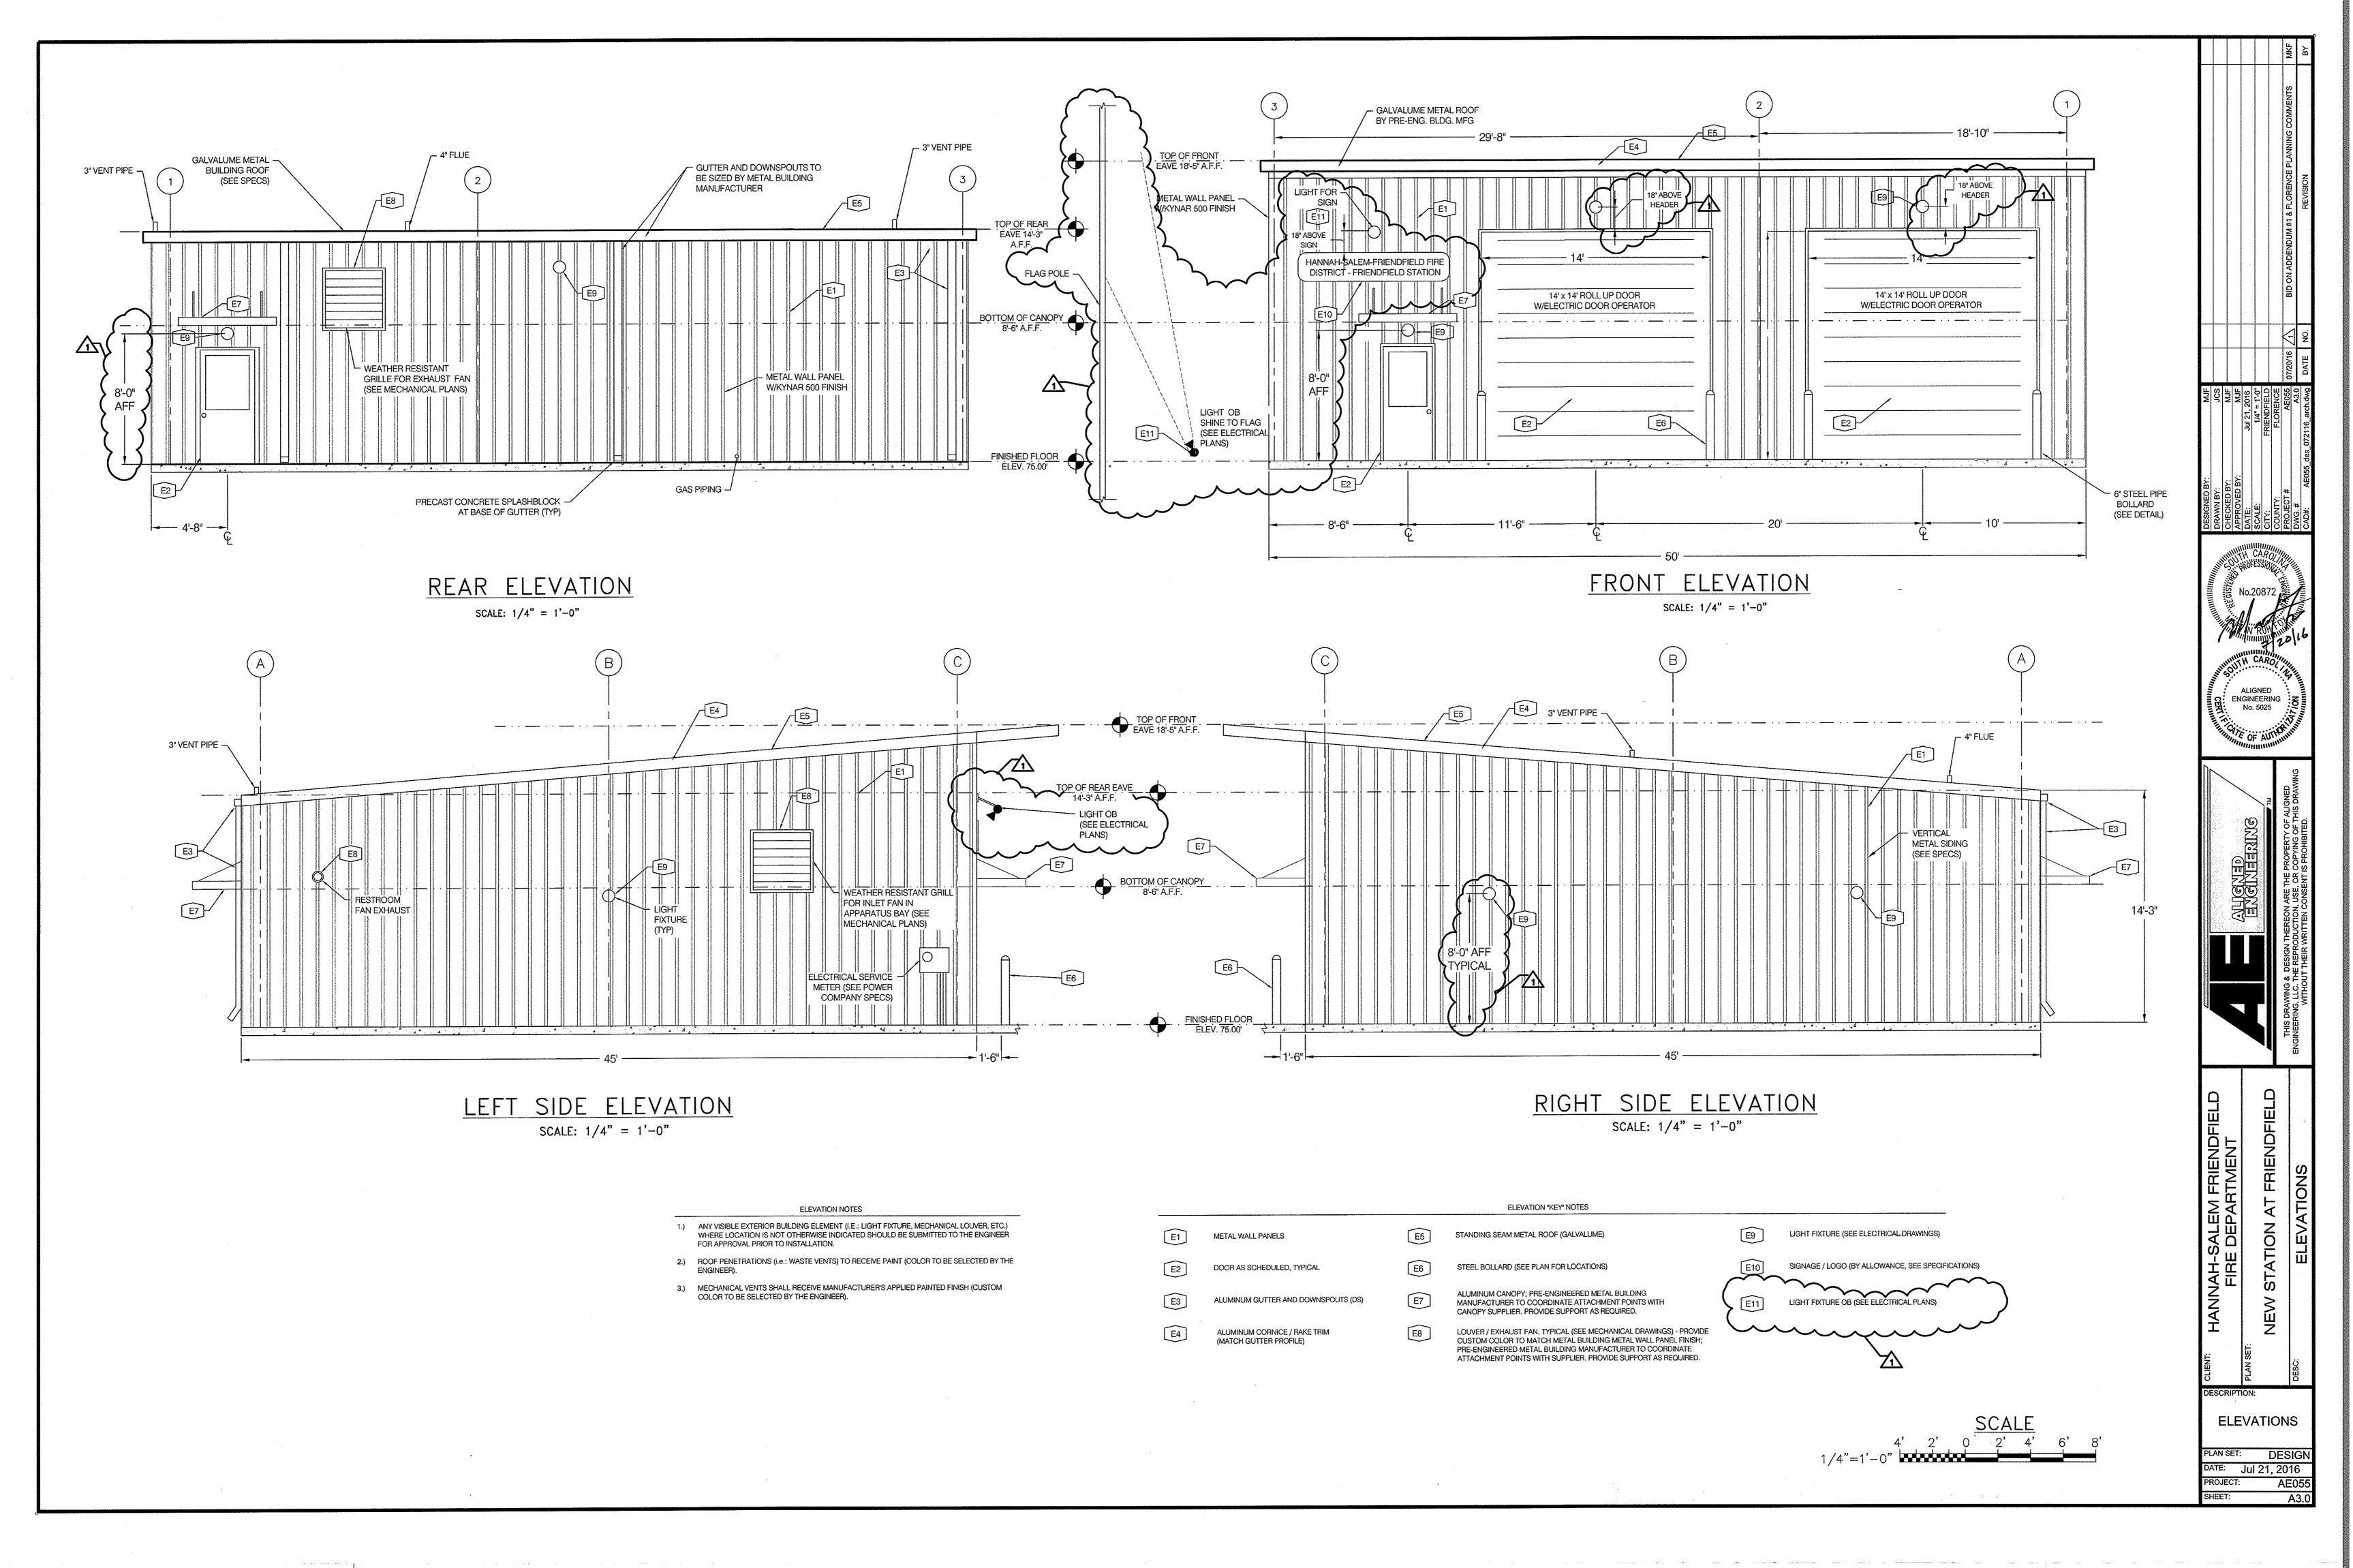

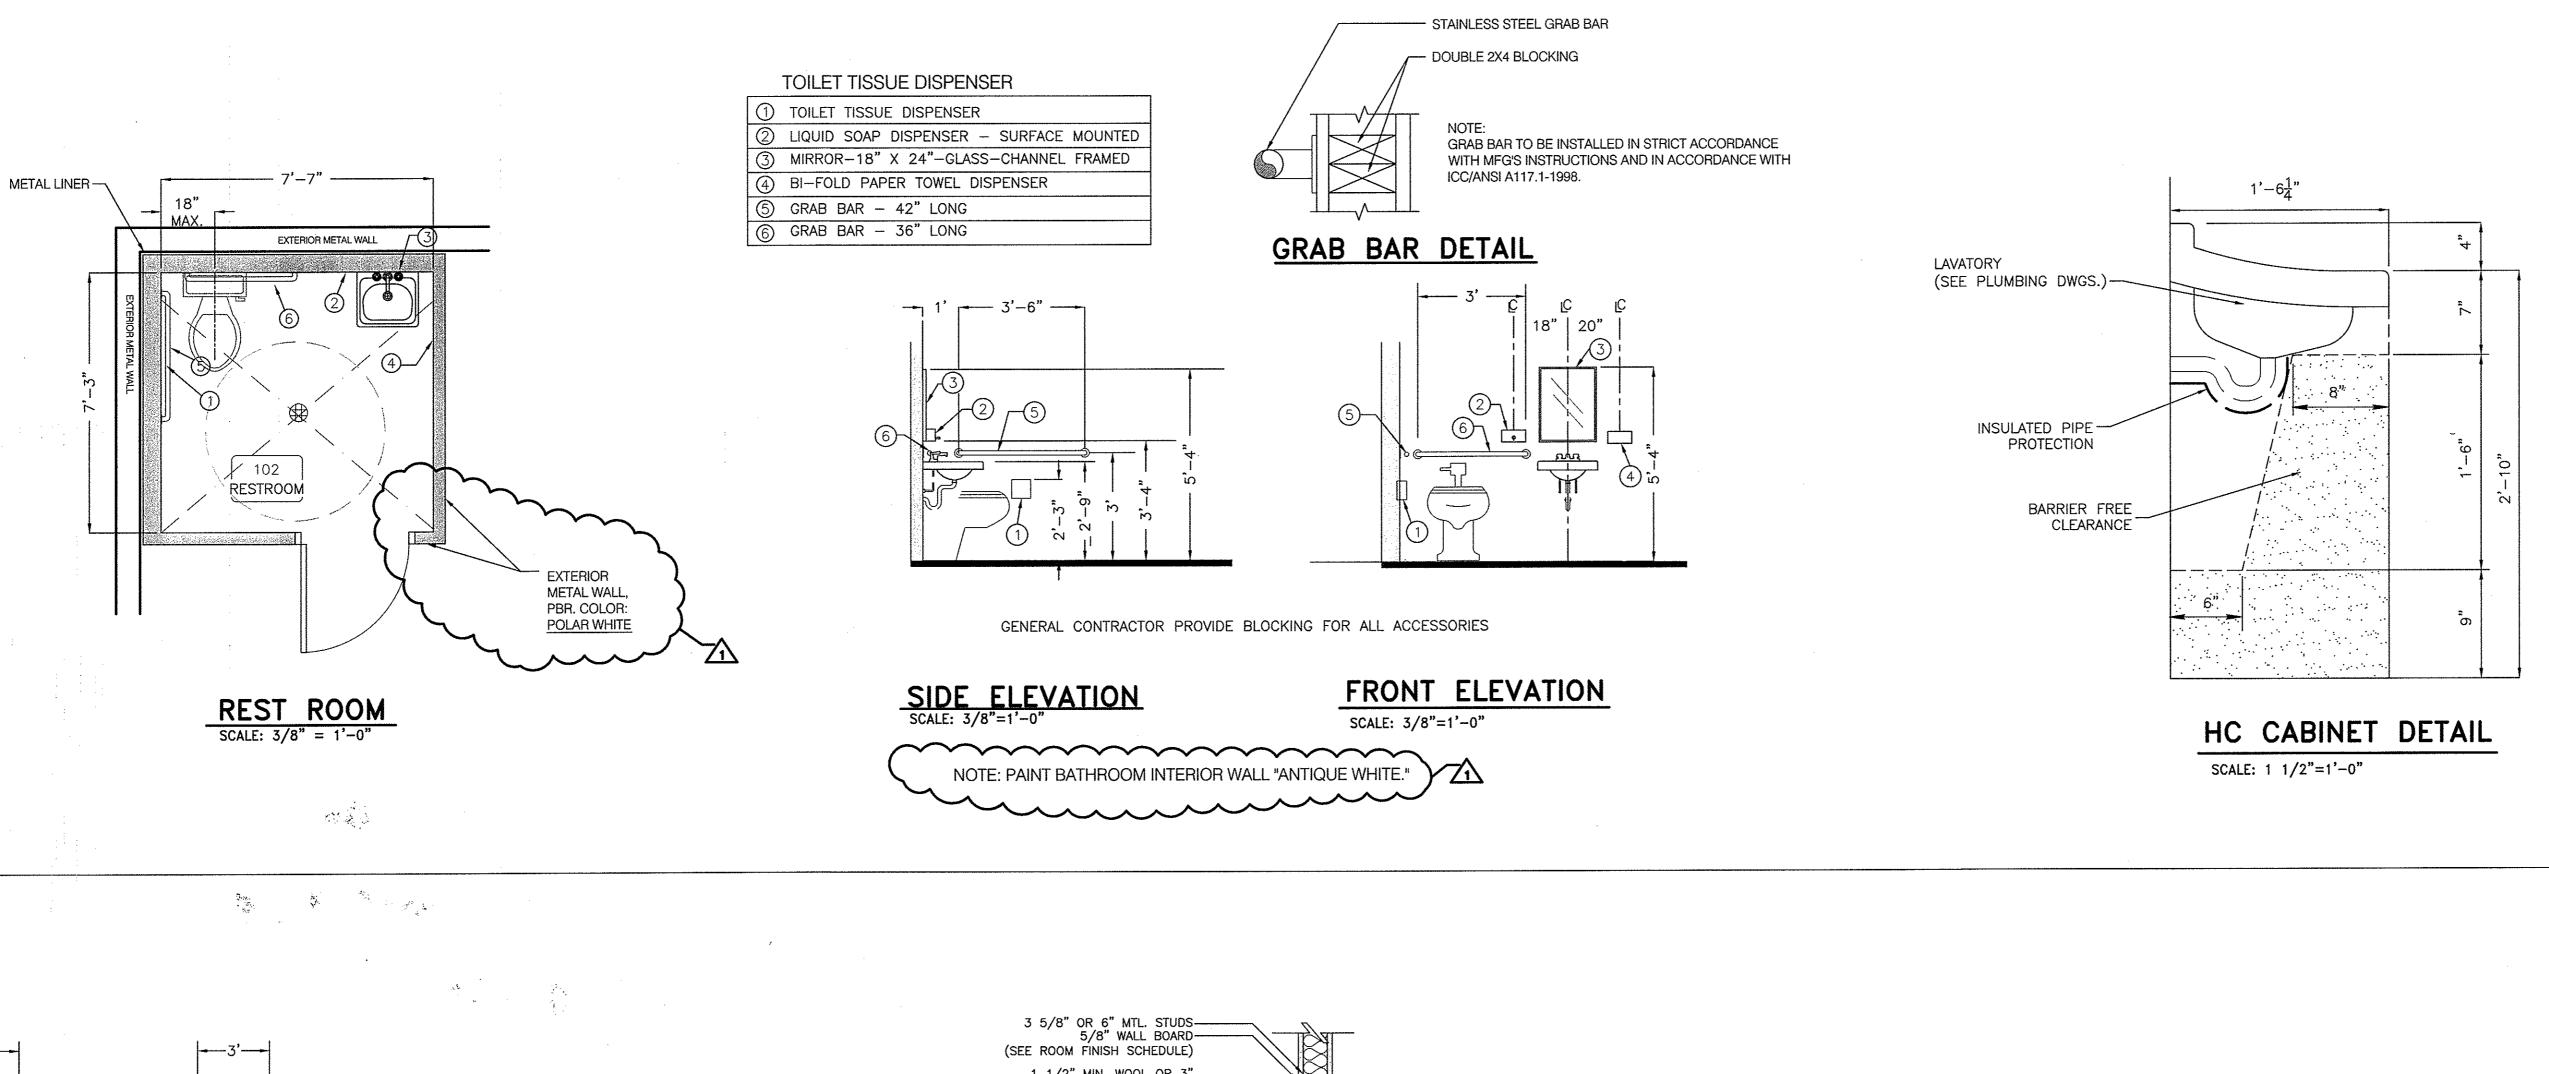

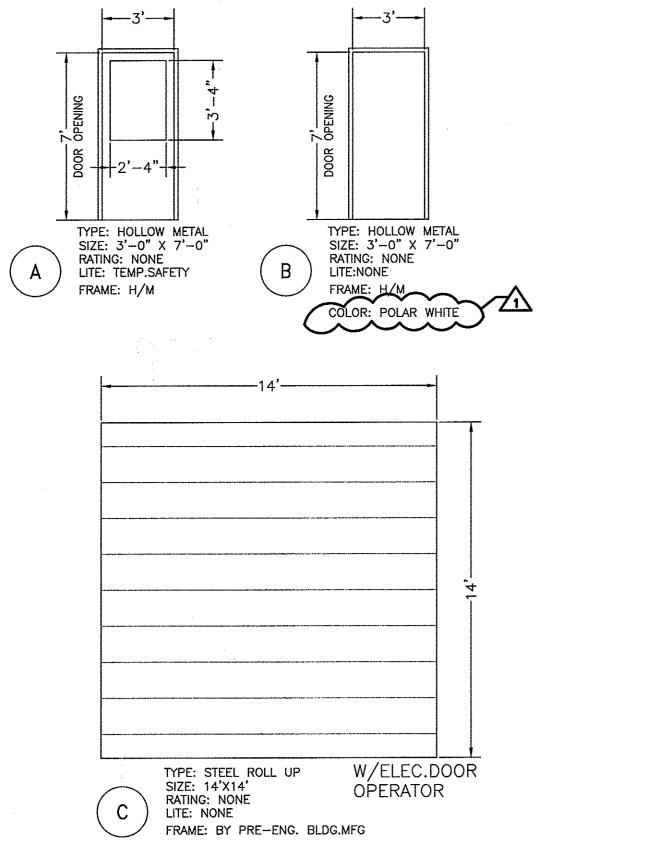

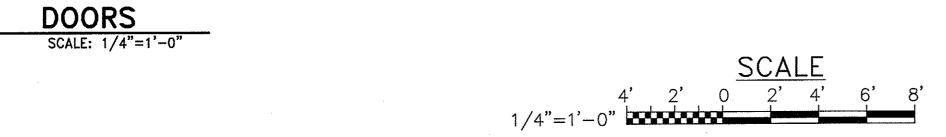

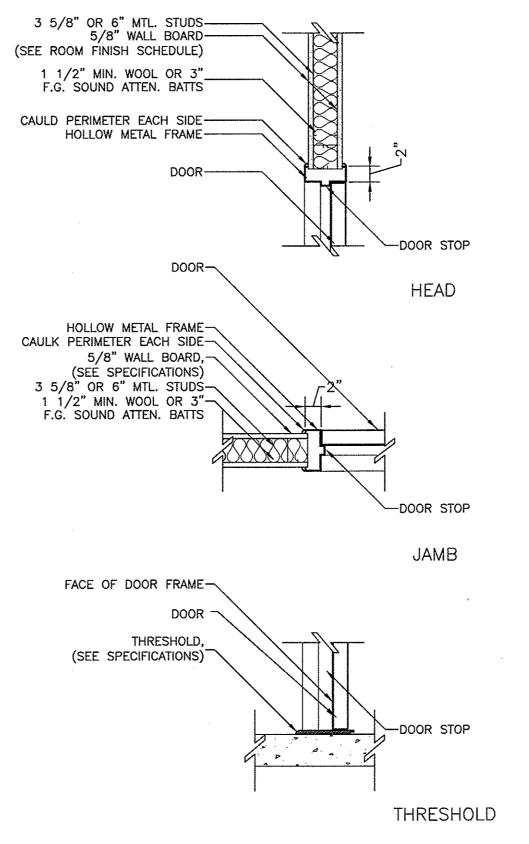

INTERIOR DOOR FRAME DETAILS

DOORS DETAILS

SCALE: 1/4"=1'-0"

T

DFIELD

THIS DRAWING & DESIGN THEREON ARE THE PROPERTY OF ALIGNED WITHOUT THEIR WRITTEN CONSENT IS PROHIBITED.


ES


HANNAH-SALEM FRIENDFIELD FIRE DEPARTMENT INEW STATION AT FRIENDFIELD DETAILS & SCHEDULES

DETAILS &
SCHEDULES

AN SET: DESIG

PLAN SET: DESIGN
DATE: Jul 21, 2016
PROJECT: AE055
SHEET: A4.0

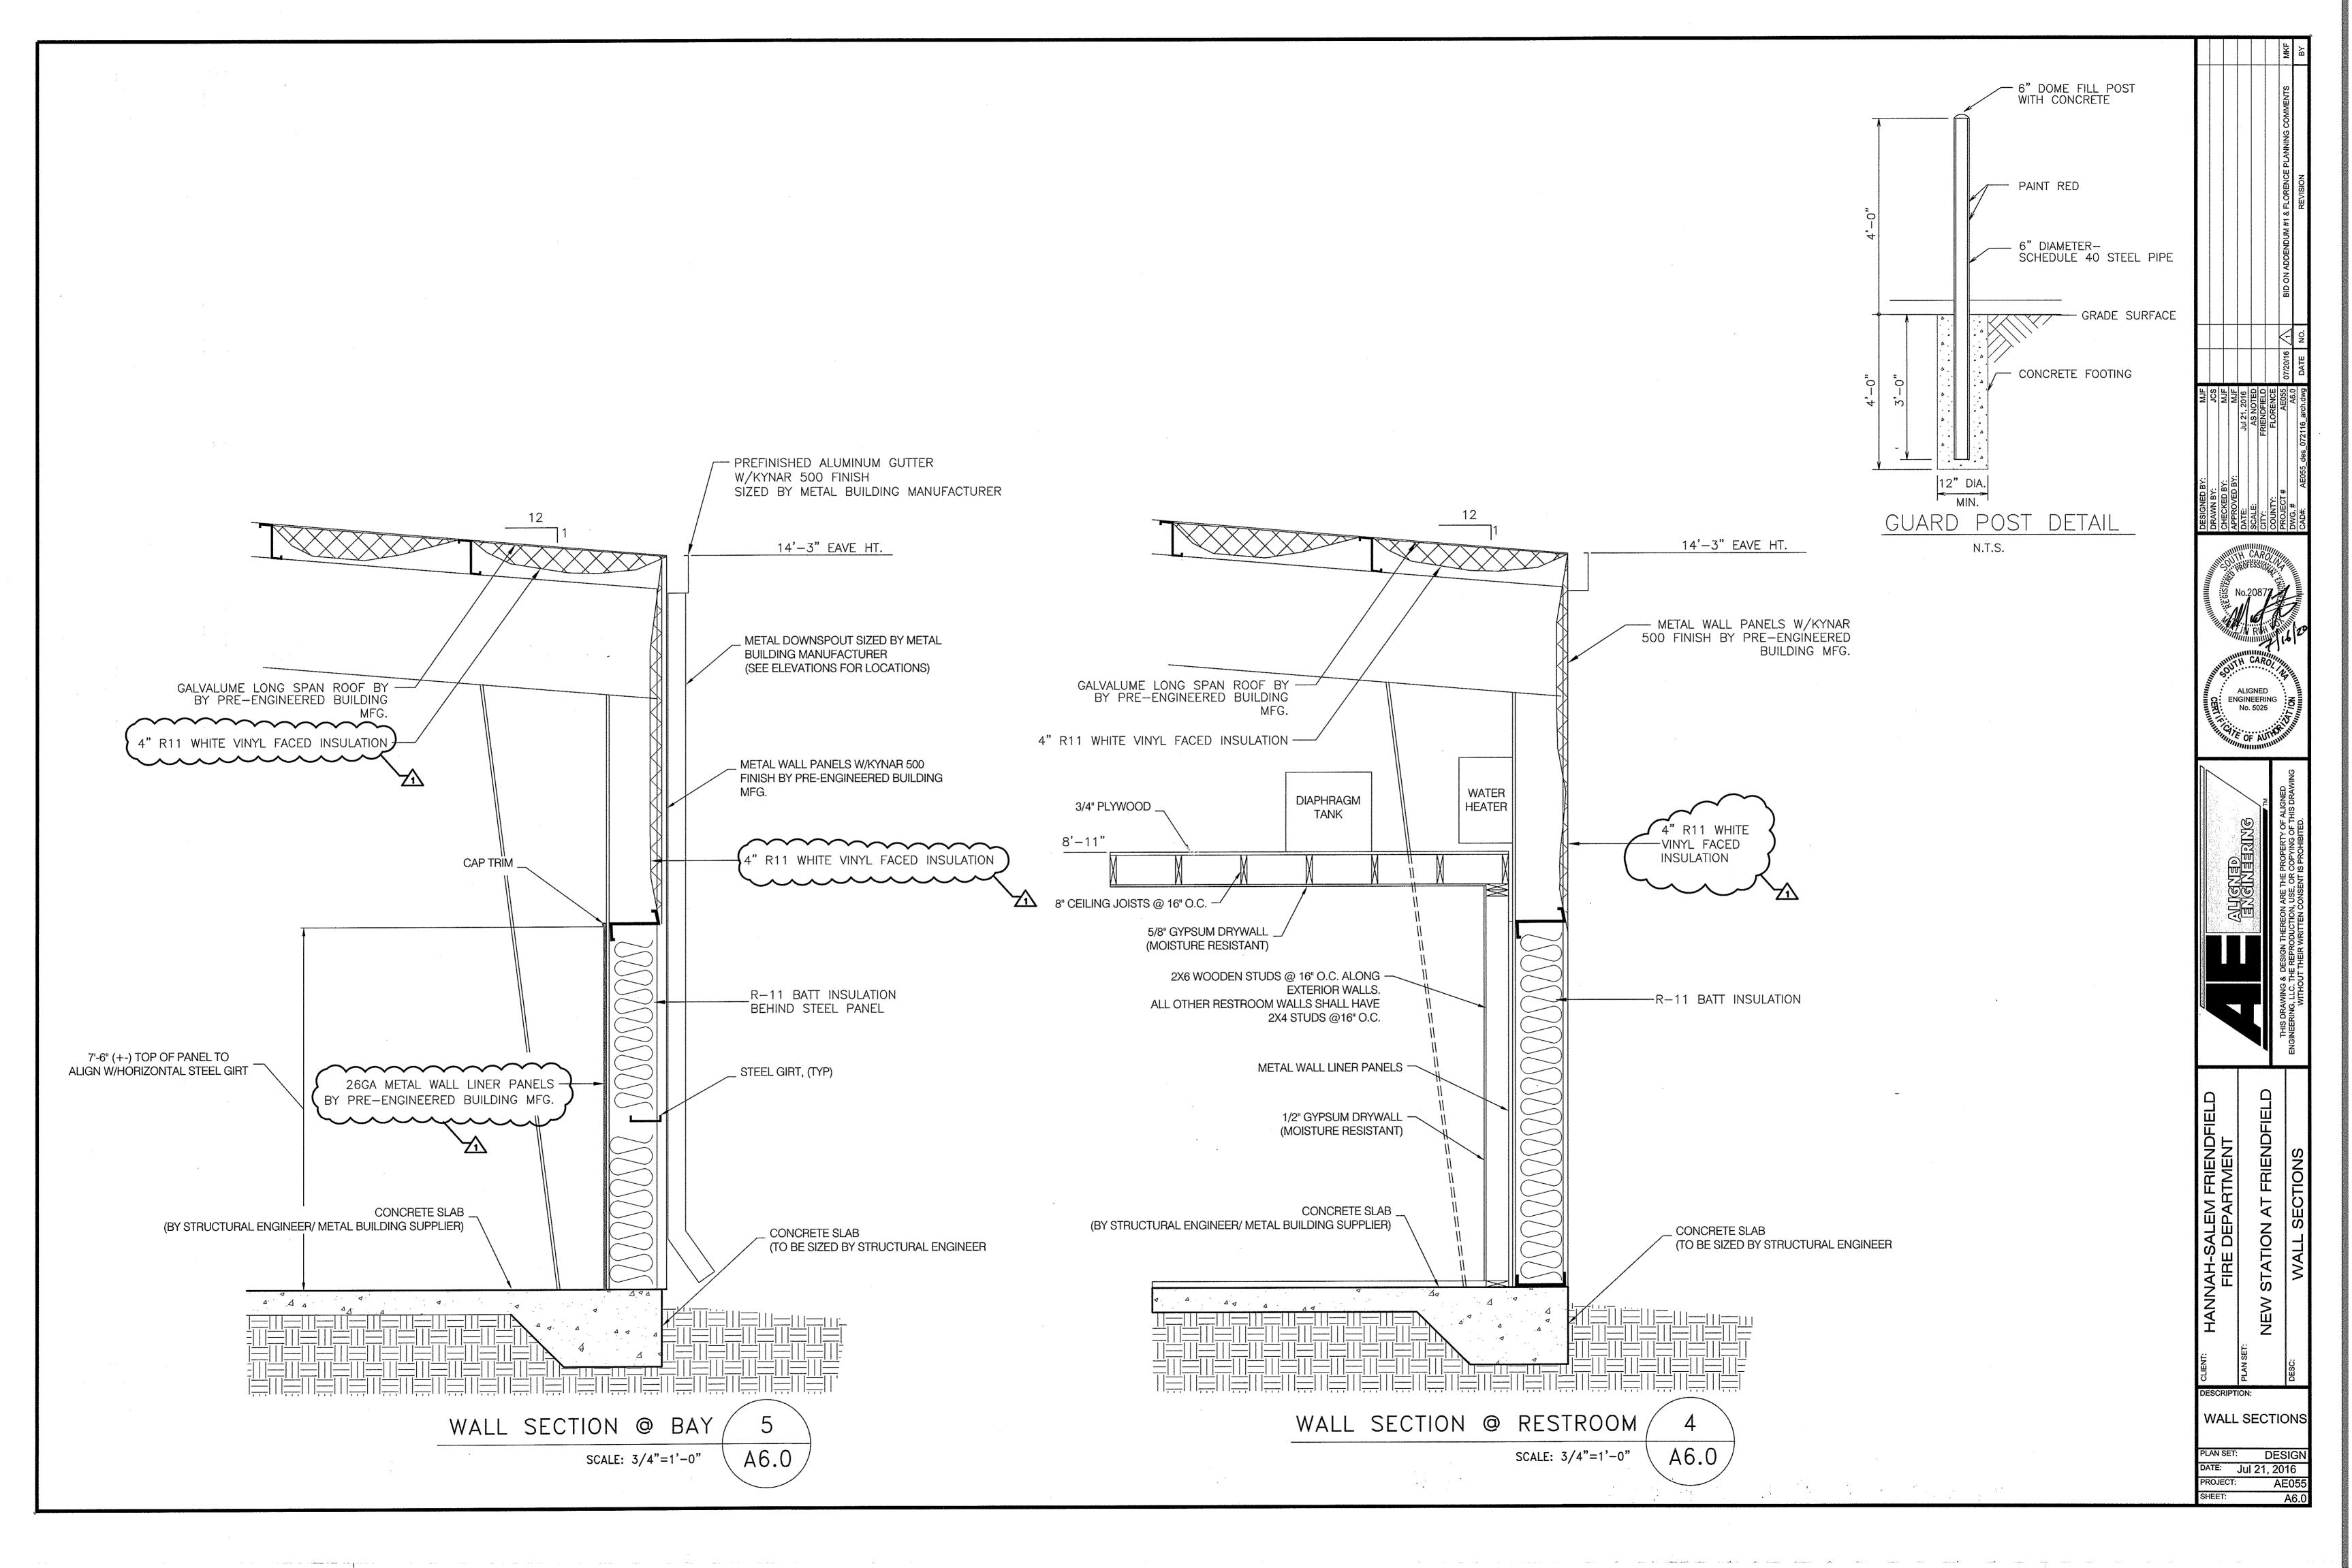

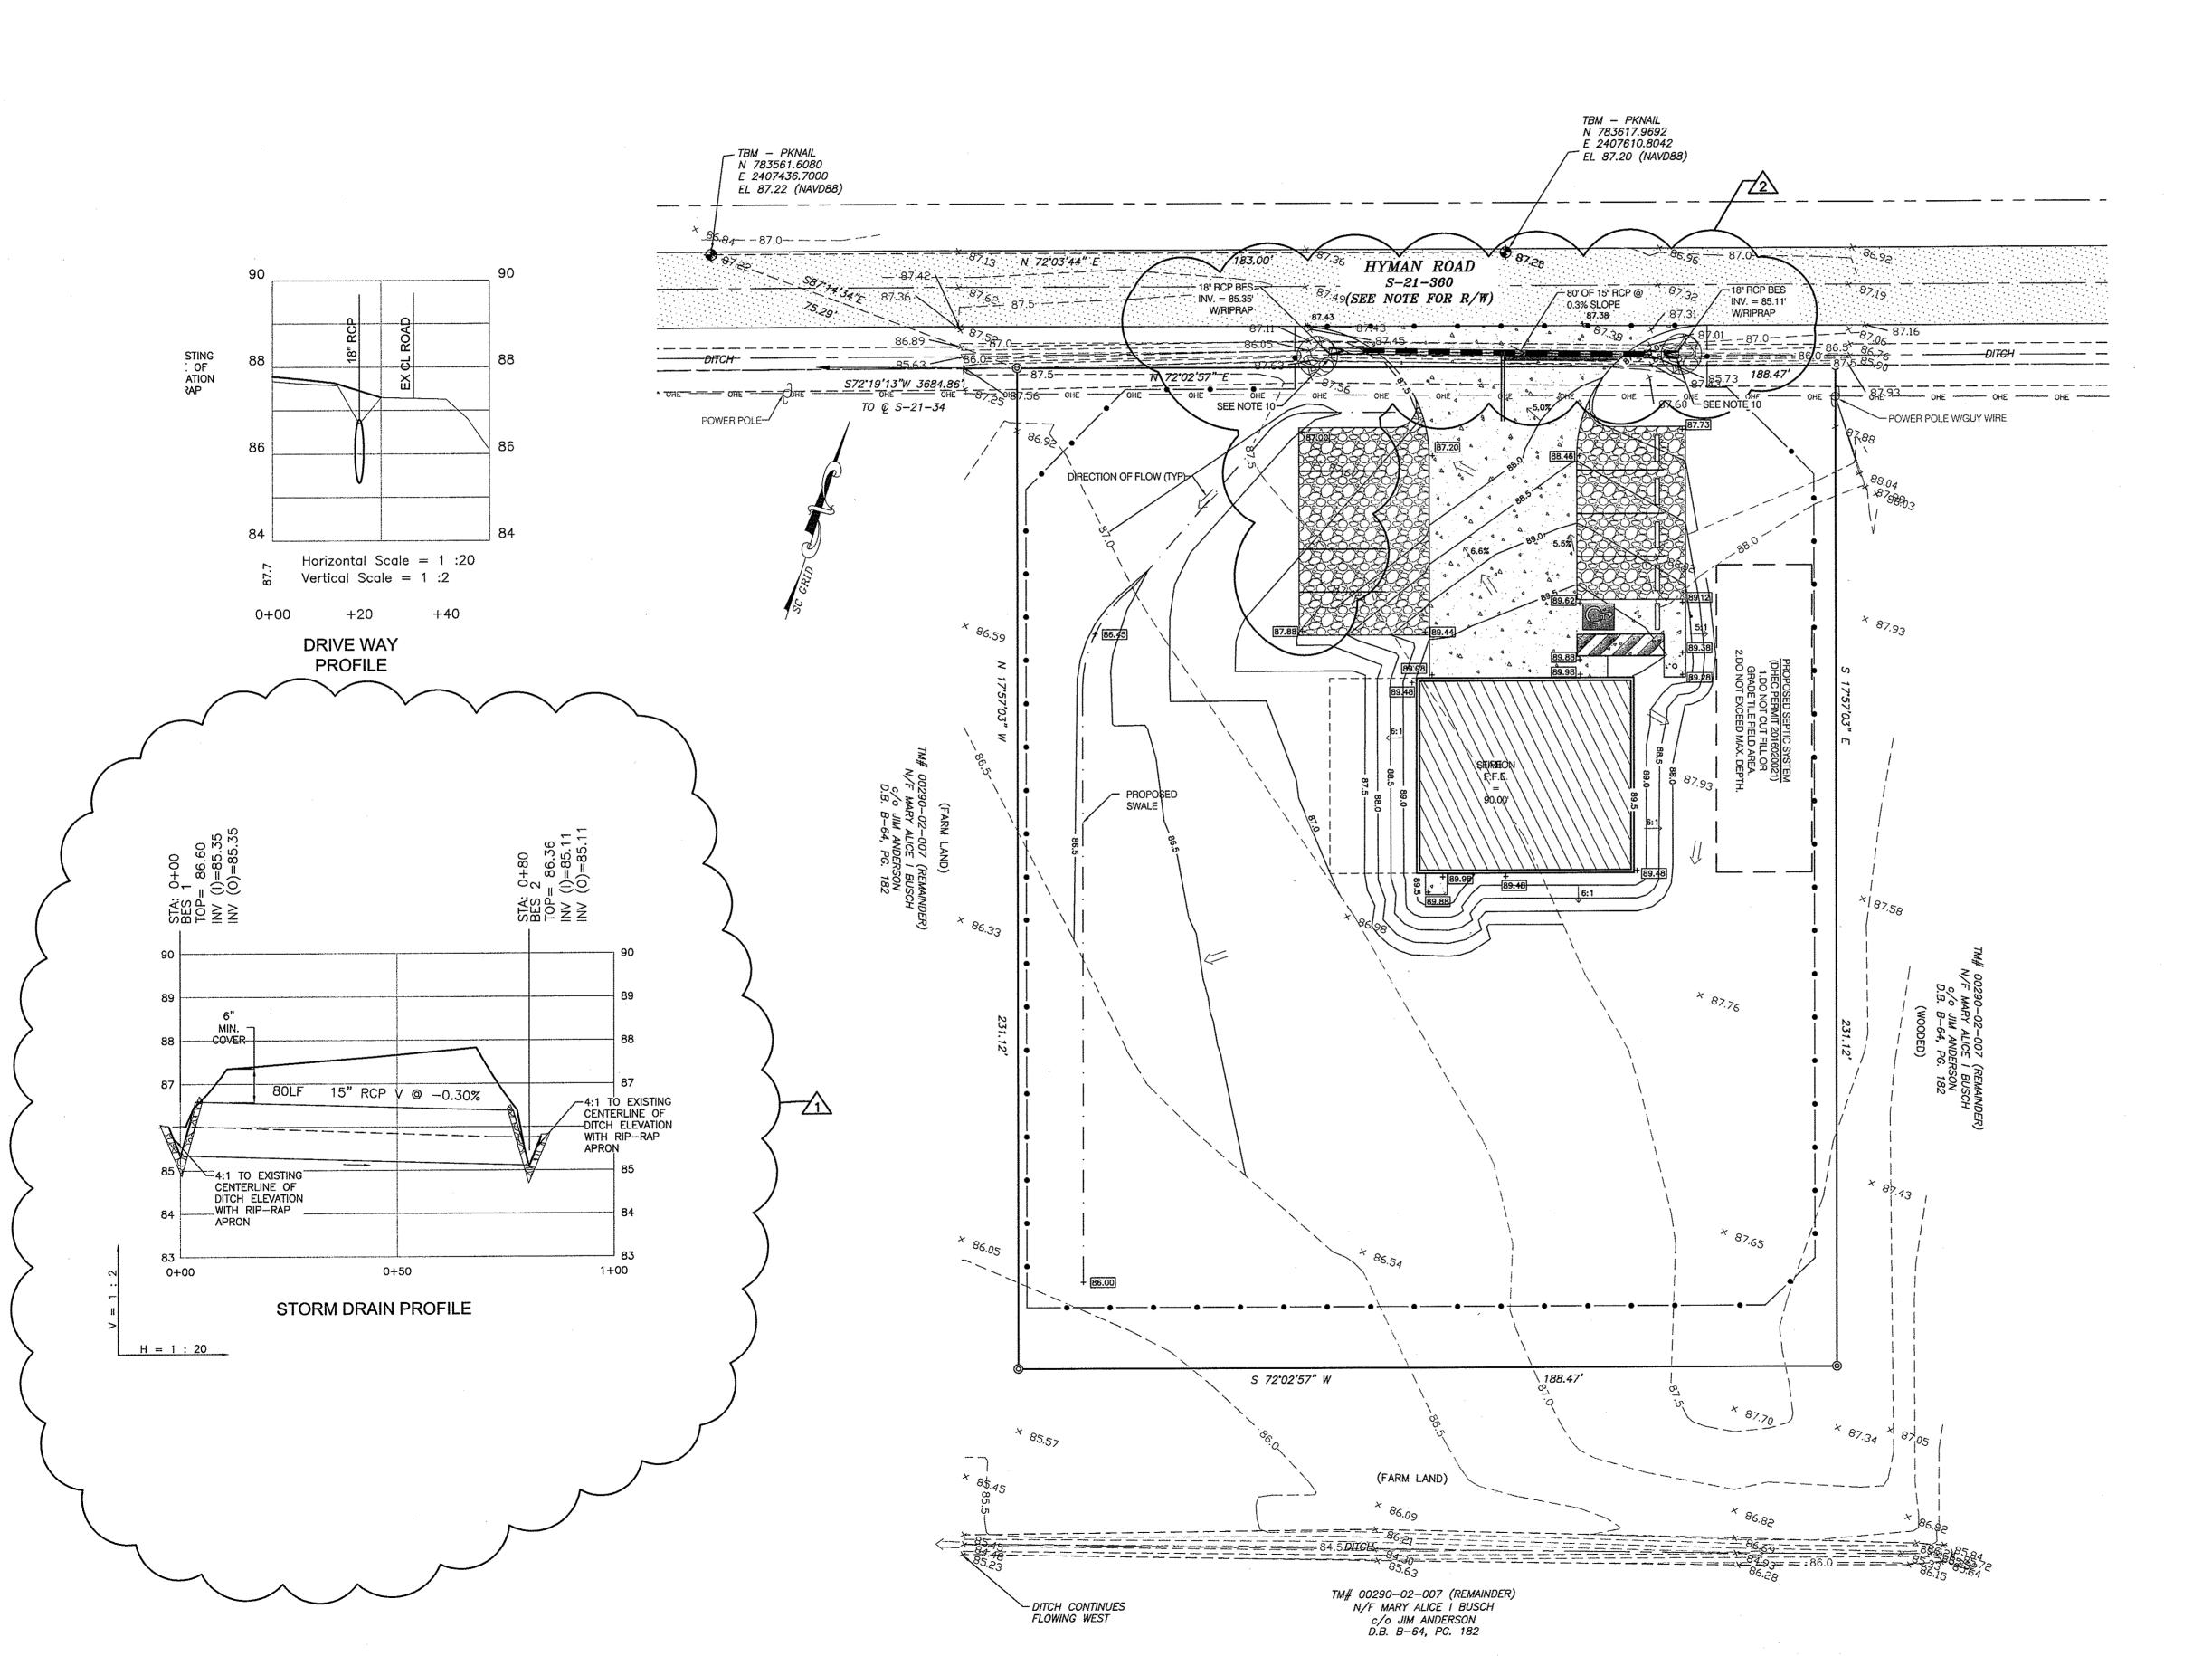

GENERAL CONSTRUCTION NOTES:

1. THE AREA WITHIN THE SITE THAT HAS PROPOSED BUILDINGS, ROADS, UTILITY CONSTRUCTION, OR FILL SHALL BE STRIPPED OF ALL ASPHALT, DEBRIS, TOPSOIL, AND ORGANIC MATERIAL. TOPSOIL SHALL BE STOCK PILED FOR REPLACING ON DISTURBED AREAS.

2. THE SUB-GRADE UNDER THE LOT & DRIVES SHOULD BE COMPACTED TO 98% OF ASTM DESIGNATION D-698 WITHIN 3% OF ITS OPTIMUM MOISTURE CONTENT.

3. THE AREA UNDER THE LOT & DRIVES SHALL BE FILLED IN WITH WELL GRADED GRANULAR, NON-EXPANSIVE MATERIAL. IT SHOULD BE PLACED IN LAYERS OF NOT MORE THAN 8 INCHES IN THICKNESS AT OPTIMUM MOISTURE AND COMPACTED TO 98% OF MAXIMUM DRY DENSITY.

4. DRIVES - AFTER THE SUB-GRADE SOILS HAVE BEEN PROPERLY COMPACTED, FINE GRADED AND PROOF-ROLLED, THE GRANULAR BASE COURSE MAY BE PLACED. THIS SHOULD CONSIST OF CRUSHED STONE AGGREGATE WHICH CORRESPONDS TO THE GRADATION REQUIREMENTS OF MACADAM BASE, SECTION 305 OR GABC SECTION 306 OF THE SOUTH CAROLINA HIGHWAY DEPARTMENT SPECIFICATIONS, 2007 EDITION. THE SELECT AGGREGATE BASE SHALL BE COMPACTED TO 100% OF ASTM DESIGNATION D-698 MAXIMUM DRY DENSITY.

5. SEE DETAILS SHEET FOR PAVING, BASE, AND SUB-GRADE THICKNESS.

GRADING & STORM DRAINAGE NOTES:

1.) ALL LAND DISTURBANCE ACTIVITIES ARE TO REMAIN WITHIN THE LIMITS OF CONSTRUCTION AS APPROVED BY SC DHEC AND DELINEATED ON THE GRADING PLANS. THIS SITE WILL BE MASS-GRADED.

2.) SEE SEDIMENT & EROSION CONTROL DETAILS SHEET FOR GRASSING AND SEDIMENT CONTROL INFORMATION. CONTRACTOR SHALL SPREAD TOPSOIL ON ROAD SHOULDERS, EASEMENTS, OR OTHER AREAS PRIOR TO GRASSING.

3.) THE CONTRACTOR SHALL RESTORE EXISTING YARD AREAS TO SAME CONDITION AS THAT PRIOR TO CONSTRUCTION. THIS INCLUDES ROAD SHOULDERS, EASEMENTS, LOT GRADES, DITCHES, GRASSED OR VEGETATED AREAS, SILT FENCES OR ANY OTHER SEDIMENT CONTROL STRUCTURE.

4.) THE CONTRACTOR IS TO NOTIFY THE ENGINEER OF ANY KNOWN DRAINAGE, SEWER OR WATER CONFLICTS PRIOR TO START OF WORK. IF ANY UNEXPECTED OR UNUSUAL CONDITIONS ARE ENCOUNTERED THAT MAY OR MAY NOT BECOME A CONFLICT, THE CONTRACTOR IS TO NOTIFY THE

5.) REFER TO MECHANICAL DRAWINGS FOR DETAILS CONCERNING UTILITY LINES. COORDINATE ALL UTILITY SERVICE LINE TIE-INS WITH BUILDING CONTRACTOR.

6.) NO CONSTRUCTION IS TO TAKE PLACE WITHIN EXISTING ROAD RIGHTS OF WAY UNTIL THE APPROPRIATE ENCROACHMENT PERMITS HAVE BEEN RECEIVED FROM SCDOT OR THE APPROPRIATE CITY/COUNTY AUTHORITIES. RESTORATION OF SHOULDERS AND PAVEMENT WITHIN STREET OR HIGHWAY RIGHT-OF-WAY SHALL BE IN ACCORDANCE WITH SPECIFICATIONS CONTAINED IN THE ENCROACHMENT PERMIT ISSUED BY THE PROPER AUTHORITY.


7.) DURING STAKING, THE STAKING CONTRACTOR SHALL MAKE SUCH ADDITIONAL MEASUREMENTS AS ARE NECESSARY TO FIELD VERIFY THAT USE OF THE COORDINATES SHOWN ON THIS DRAWING PLACES THE PROPOSED SITE IMPROVEMENT IN ITS CORRECT AND PROPER LOCATION. ANY SIGNIFICANT DISCREPANCY NOTED DURING THE STAKING OPERATION SHALL BE BROUGHT TO THE ATTENTION OF THE ENGINEER PRIOR TO CONSTRUCTION OF THE PORTION OF WORK IN QUESTION.

8.) THE LOCATION OF ALL UTILITY LINES SHOWN ON THIS DRAWING ARE APPROXIMATE AND ARE SHOWN FOR THE CONTRACTOR'S CONVENIENCE ONLY. THERE MY BE OTHER UTILITIES NOT SHOWN ON THESE PLANS. THE APPROPRIATE UTILITY COMPANIES SHOULD BE CONTACTED PRIOR TO ANY EXCAVATION TO PROVIDE LOCATION ASSISTANCE. THE ENGINEER ASSUMES NO RESPONSIBILITY FOR THE LOCATIONS SHOWN AND IT SHALL BE THE CONTRACTOR'S RESPONSIBILITY TO VERIFY THE LOCATIONS OF ALL UTILITIES WITHIN THE LIMITS OF THE WORK. ALL DAMAGE MADE TO EXISTING UTILITIES BY THE CONTRACTOR SHALL BE THE SOLE RESPONSIBILITY OF THE CONTRACTOR.

9.) ALL DHEC SEDIMENT CONTROL STRUCTURES MUST REMAIN IN PLACE UNTIL ALL LOTS ARE DEVELOPED OR UNTIL FINAL APPROVAL HAS BEEN GIVEN BY DHEC.

10.) ALL DRIVEWAY CULVERTS SHALL BE INSTALLED AND SEALED ACCORDING TO SCDOT TYPICAL 714-205-01, ON PROPER GRADE TO ALLOW FOR POSITIVE STORM WATER FLOW WITHIN THE PIPE AND TO/FROM ADJACENT PIPES/CROSS LINES. INSTALL BEVELED END SECTIONS WITH RIPRAP ACCORDING TO SCDOT TYPICAL 719-610-00.

PROPERTY LINE	
OVER HEAD ELECTRIC	OHE -
PROPOSED CONCRETE	4 6
PROPOSED GRAVEL	\$48.60
LIMITS OF DISTURBANCE	
EXISTING CONTOUR	— — 129.00 — —
PROPOSED DRAINAGE PIPE	
EXISTING SPOT ELEV.	+ 129.00
FINISHED SPOT ELEV.	+ 129.00

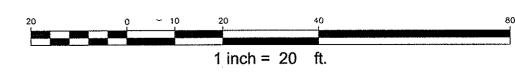

APPROVED BY: MJF

DATE: Jul 21, 2016


SCALE: 1"=20'
CITY: FRIENDFIELD

COUNTY: FLORENCE 07-0

PROJECT # AE055

DWG. # C30

CAD#: AE055 Friendfield DES 072116.dwg D/o

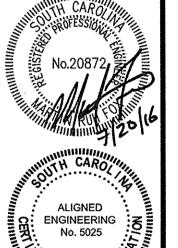

SING & DESIGN THEREON ARE THE PROPERTY OF ALIGNED LLC. THE REPRODUCTION, USE, OR COPYING OF THIS DRAWING MITTEN CONSENT IS PROHIBITED.

AE DEPARTMENT
ATION AT FRIENDFIELD

FIRE DEPA

DESCRIPTION:
GRADING &
DRAINAGE PLAN
PLAN SET: DESIGN

PLAN SET: DESIGN

DATE: Jul 21, 2016

PROJECT: AE055

SHEET: C3.0

▼ TELEPHONE OUTLET

TELEPHONE OUTLET MOUNTED ABOVE COUNTER BACKSPLASH, OR AT HEIGHT NOTED.

◀ TELE/DATA OUTLET.

◆ TELE/DATA OUTLET MOUNTED ABOVE COUNTER BACKPLASH, OR AT HEIGHT NOTED

<u>FELECOMMUNICATIONS (ET) NOTES</u>
ET-1 FURNISH A COMPLETE TELEPHONE CONDUIT SYSTEM AS INDICATED ON THE DRAWINGS.

TELECOMMUNICATION OUTLETS (TELEPHONE OR TELE/DATA) SHALL CONSIST OF A 4" SQUARE DEEP BOX WITH SINGLE GANG PLASTER RING.

PROVIDE MINIMUM 1" RACEWAY, UNLESS OTHERWISE NOTED, FROM EACH BOX TO ABOVE NEAREST ACCESSIBLE CEILING SPACE OR CABLE TRAY AS APPLICABLE, PROVIDE MINIMUM

PROVIDE RACEWAYS FOR ALL EXTERIOR AND/OR EXPOSED LOCATIONS.

PROVIDE GROUNDING FOR ALL TELEPHONE/DATA SYSTEMS AND EQUIPMENT PER REQUIREMENTS AND SPECIFICATIONS PROVIDED BY THE OWNERS DESIGNATED VENDOR.

210# TEST NYLON PULL CORD AND NYLON BUSHINGS IN ALL EMPTY RACEWAYS.

ALL LOW-VOLTAGE CABLING SHALL BR PLENUM-RATED.

ALL OUTLET BOXES (INCLUDING TELEPHONE, CABLE TV, AND COMPUTER) SHALL HAVE COVER PLATES, BLANK IF NOT USED.

MECHANICAL / ELECTRICAL LEGEND

MECHANICAL/ELECTRICAL DISCONNECTS

NON-FUSED HEAVY DUTY DISCONNECT SWITCH. NUMERALS INDICATE SWITCH RATING.

FUSED HEAVY DUTY DISCONNECT SWITCH, NUMERALS INDICATE SWITCH RATING.

BAY DOOR MOTOR CONTROL. MOUNT +48" AFF, CONTROLS SHALL BE UP, DOWN, AND STOP, MOUNTED ON 4" SQUARE BOX (FLUSH BOX)

CONNECTION TO MOTOR. STARTER PROVIDED BY OTHERS UNLESS OTHERWISE NOTED

DISCONNECT SWITCHES SHALL BE HEAVY-DUTY TYPE IN NEMA 1 ENCLOSURES, UNLESS

DISCONNECTS SHALL BE FUSED OR NON-FUSED AS INDICATED ON PLANS. SWITCHES WILL HAVE REJECTION-TYPE FUSE CLIPS.

APPROVED MANUFACTURERS: EATON, SQUARE-D, GENERAL ELECTRIC, OR APPROVED EQUAL

FUSES SHALL BE CLASS RK-5, DUAL-ELEMENT, TIME-DELAY WITH INDICATION.

A SET OF THREE FUSES OF EACH SIZE AND TYPE SHALL BE FURNISHED TO THE OWNER. MECHANICAL/ELECTRICAL COORDINATION (MEC) NOTES

ELECTRICAL CONTRACTOR SHALL CONNECT AND/OR PROVIDE FINAL CONNECTIONS TO

ALL PLUMBING AND MECHANICAL EQUIPMENT.

ELECTRICAL CONTRACTOR SHALL COORDINATE ALL CONNECTIONS PRIOR TO ROUGH -IN USING APPROVED CATALOG SHEETS AND SHOP DRAWINGS.

MEC-03 THE ELECTRICAL CONTRACTOR SHALL PROVIDE AND INSTALL ALL MANUAL STARTER SWITCHERS, DISCONNECT SWITCHES, RECEPTORS, ETC. TO MECHANICAL/PLUMBING EQUIPMENT. ALL STARTERS (OTHER THAN MANUAL STARTER SWITCHES) SHALL BE PROVIDED BY OTHERS, BUT INSTALLED BY ELECTRICAL CONTRACTOR.

DRAWINGS PRIOR TO INSTALLATION, ANY EQUIPMENT INSTALLED INCORRECTLY BECAUSE OF OR LACK OF COORDINATION WILL BE REMOVED AND INSTALLED CORRECTLY AT THE ELECTRICAL CONTRACTOR'S EXPENSE.

MEC-04 ALL DISCONNECT SWITCHES AND FUSE SIZES SHALL BE COORDINATED WITH SHOP

MEC-05 ELECTRICAL CONTRACTOR SHALL INSTALL ALL STARTERS PROVIDED BY OTHER TRADES.

THE ELECTRICAL CONTRACTOR SHALL COORDINATE ALL CONDUIT RUNS & LIGHT FIXTURE LOCATIONS ABOVE THE CEILING WITH OTHER TRADES PRIOR TO INSTALLATION.

ELECTRICAL (E) NOTES

CONDUIT SHALL BE MANUFACTURED BY ALLIED, WHEATLAND, REPUBLIC CONDUIT, WESTERN TUBE, OR APPROVED EQUIVALENT.

MINIMUM CONDUIT SIZE SHALL BE 3/4' FOR INTERIOR WORK, 1" FOR EXTERIOR WORK.

FOR INTERIOR WORK, CONDUIT SHALL BE ZINC COATED EMT EXCEPT WHERE NOT PERMITTED BY CODE. USE SCHEDULE 40 PVC BELOW CONCRETE SLAB AND FOR EXTERIOR WORK WHERE NOT SUBJECT TO DAMAGE. USE IMC WHERE SUBJECT TO PHYSICAL

PROVIDE MINIMUM 210# TEST NYLON PULL CORD AND NYLON BUSHINGS IN ALL EMPTY

EMT FITTINGS SHALL BE COMPRESSION GLAND TYPE, OF MALLEABLE STEEL. CONNECTORS SHALL HAVE INSULATED THROATS. CAST, SET SCREW, OR INDENTER TYPE FITTINGS ARE NOT ACCEPTABLE. ALL FITTINGS FOR EMT SHALL BE MADE OF STEEL.

EC-6 ALL CONDUIT/RACEWAY SHALL BE RUN CONCEALED, UNLESS OTHERWISE NOTED. FISH ALL NEW OUTLETS IN EXISTING WALLS, WHERE POSSIBLE.

ALL RUNS SHALL BE NEAT AND SQUARE; ALL CONDUIT SHALL BE RUN PARALLEL OR PERPENDICULAR TO BUILDING LINES, WHETHER EXPOSED OR NOT.

SUPPORT ALL CONDUIT WITH STRAPS AND CLAMPS. ALL CONDUIT SHALL BE SUPPORTED FROM STRUCTURE AND PROPERLY SECURED.

WHERE CONDUITS PASS THROUGH A BUILDING EXPANSION JOINTS, PROVIDE GALVANIZED EXPANSION FITTINGS WITH BONDING JUMPERS.

EC-10 RACEWAY PENETRATIONS THROUGH FLOOR SLABS AND FIRE-RATED WALLS SHALL BE FILLED WITH IMPERVIOUS, NON-SHRINK GROUT SUFFICIENTLY TIGHT TO PREVENT THE TRANSFER OF SMOKE, WATER, AND DUST. ROOF PENETRATIONS SHALL BE WITHIN THE

EC-11 LOW VOLTAGE CABLING NOT SPECIFIED TO BE INSTALLED IN CONDUIT, SHALL BE INSTALLED IN A CABLE TRAY SYSTEM OR J-HOOK SYSTEM CONSISTING OF MINIMUM 2" DIAMETER HOOKS LOCATED ON 3'-0" CENTERS IN ALL ACCESSIBLE CEILINGS, WHERE THERE ARE INACCESSIBLE CEILINGS, PROVIDE CONDUIT FOR ENTIRE LENGTH OF

FOLIPMENT ROOF CURR

EC-12 RACEWAYS USED FOR LOW VOLTAGE SYSTEMS SUCH AS TELECOMMUNICATIONS, FIRE ALARM, SECURITY, CCTV, CONTROLS, AND SIMILAR CONDUITS ABOVE THE CEILING AND BACKBOARD(S) SHALL BE PROVIDED WITH INSULATED THROAT BUSHINGS AT EACH CONDUIT TERMINATION. THESE BUSHINGS SHALL BE INSTALLED PRIOR TO PULLING LOW-VOLTAGE CABLES.

EC-13 LIQUID-TIGHT METAL CONDUIT SHALL ONLY BE USED FOR FINAL CONNECTIONS TO EQUIPMENT AND ALL OTHER ROTATING AND VIBRATING EQUIPMENT, MAXIMUM LENGHT OF

EC-14 FLEXIBLE METAL CONDUIT, MINIMUM SIZE 3/8", SHALL ONLY BE USED FOR FINAL CONNECTION TO LIGHTING FIXTURES, MAXIMUM LENGTH OF 6'-0".

EC-15 PROVIDE PULL BOXES, SUCH THAT NO SINGLE CONDUIT RUN HAS BENDS IN EXCESS OF 360. PULL BOXES SHALL BE SUITABLE AND APPROVED FOR THE INTENDED USE. WHERE CONDUITS PASS UNDER PAVED AREAS, THEY SHALL BE RGS.

EC-16 ALL CONDUIT BENDS/ELBOWS EMERGING FROM UNDERGROUND SHALL BE IMC AND SHALL EXTEND A MINIMUM OF 18" BELOW GRADE.

ALL UNDERGROUND RACEWAYS SHALL BE THOROUGHLY COATED WITH TWO COATS OF ASPHALTUM BITUMASTIC.

EC-18 ALL CONDUITS INSTALLED UNDERGROUND OR IN CONCRETE SHALL HAVE JOINTS MADE WATERTIGHT BY USE OF POLYETRA-FLUOROETHYLENE TAPE.

EC-19 THE USE OF AC OR NM CABLE IS NOT PERMITTED.

ELECTRICAL LEGEND

ELECTRICAL DEVICES AND PATHWAYS

WIRING SYSTEM CONCEALED IN WALL OR CEILING. WHEN SHOWN, CROSS LINES INDICATE NUMBER OF WIRES. (GROUND WIRES ARE NOT SHOWN)

WIRING SYSTEM CONCEALED IN OR UNDER SLAB OR UNDERGROUND.

WIRING SYSTEM EXPOSED.

CONDUIT TURNED UP TO FLOOR ABOVE.

CONDUIT TURNED DOWN TO FLOOR BELOW

BRANCH CIRCUIT HOMERUN TO PANEL. JUNCTION BOX WITH CONNECTION TO EQUIPMENT SERVED.

WITHIN 3' OF A SINK OR IN A KITCHEN SHALL BE GFC!.

4" SQUARE BOX WITH A SINGLE-GANG OPENING AND PLASTER RING. SHORE CONNECTION (CEILING MOUNTED): WHITE CORD REEL WITH 50' CABLE AND OUTLETS. CONDUCTIX INSUL 8 PART #121120305016 RB-5-20R, OR REELCRAFT EQUAL

SINGLE RECEPTACLE, 20 AMP, 120 VOLT HUBBELL 5251, OR EQUAL

DUPLEX RECEPTACLE, 20 AMP, 120 VOLT (USE 20 AMP FOR SINGLE RECEPTACLE ON A

CIRCUIT.) HUBBELL 5352, OR EQUAL DUPLEX RECEPTACLE MOUNTED ABOVE COUNTER BACKSPLASH, OR AT HEIGHT NOTED.

GROUND FAULT RECEPTACLE. NEMA 5-20R DUPLEX. ALL RECEPTACLES INSTALLED OUTSIDE,

ELECTRICAL OUTLET BOX (EO) NOTES

JUNCTION AND PULL BOXES SHALL BE CODE GAUGE GALVANIZED STEEL. ACCEPTED MANUFACTURERS SHALL BE STEEL CITY (THOMAS & BETTS), RACO, CROUSE-HINDS, APPLETON (EMERSON), OR APPROVED EQUIVALENT.

EO-2 OUTLET BOXES SHALL NOT BE MOUNTED BACK TO BACK IN COMMON WALLS.

EO-3 ATTACH EMT WITH CONNECTORS HAVING INSULATED THROAT.

ATTACH BOXES TO STUD WORK USING CADDY BAR STRAPS THAT CONNECT TO TWO ADJACENT STUDS TO PREVENT TWISTING OF BOX IN WALL.

ALL OUTLET BOXES (INCLUDING TELEPHONE, CABLE TV, AND COMPUTER) SHALL HAVE COVER PLATES, BLANK IF NOT USED.

EO-6 ALL EXTERIOR BOXES SHALL BE WATER-TIGHT.

ELECTRICAL WIRING DEVICE (ED) NOTES

WIRING DEVICES SHALL BE SPECIFICATION GRADE, MINIMUM, EQUAL TO COOPER QUALITY INDICATED BELOW OR AS MANUFACTURED BY HUBBELL, LEGRAND-PASS & SEYMOUR, LEVITON, OR APPROVED EQUAL, UNLESS OTHERWISE NOTED:

SWITCHES (120/277V) SHALL BE AS FOLLOWS: COOPER AH1221 SINGLE-POLE 20 AMP COOPER AH1222 COOPER AH 1223 THREE-WAY 20 AMP FOUR-WAY 20 AMP COOPER AH 1224

DUPLEX RECEPTACLES SHALL HAVE A NYLON FACE AND SHALL BE AS FOLLOWS: COOPER 5252 15 AMP DUPLEX COOPER 5352 20 AMP DUPLEX 15 AMP DUPLEX GFCI COOPER VGF15 20 AMP DUPLEX GFCI

THE PART NUMBERS ABOVE ARE FOR WIRING DEVICE TYPE ONLY. SEE ARCHITECTURAL

SPECIFICATIONS FOR WIRING DEVICE COLOR AND PLATE MATERIAL/COLOR. SEE MOUNTING HEIGHT ELEVATION DETAIL FOR STANDARD MOUNTING HEIGHTS OF ALL

DEVICES, UNLESS OTHERWISE NOTED. EACH DUPLEX RECEPTACLE INDICATED TO BE ON A DEDICATED CIRCUIT SHALL BE 20 AMP

ADJACENT DEVICES SHALL HAVE A COMMON WALL TYPE.

WEATHERPROOF COVERS SHALL BE: "WHILE-IN-USE" SO PLUGS MAY BE INSTALLED WITHOUT COMPROMISING THE WP FUNCTION. COOPER #WIU-2 DOUBLE-GANG WITH CLEAR COVER OR APPROVED EQUAL.

ED-6 A MAXIMUM OF 10 GENERAL PURPOSE RECEPTACLES SHALL BE ON EACH BRANCH CIRCUIT ALL WALL MOUNTED OCCUMPANCY/VACANCY SENSORS/SWITCHES SHALL BE INSTALLED

GROUND-FAULT CIRCUIT-INTERRUPTER (GFCI) PROTECTION FOR PERSONNEL SHALL BE PROVIDED IN ALL LOCATIONS PER NEC 210.8. WHERE A DEVICE LOCATION IS NOT ACCESSIBLE, THE GFCI PROTECTION SHALL BE PROVIDED WITH THE BREAKER SERVING

WITH AN EQUIPMENT WITH AN EQUIPMENT GROUNDING CONDUCTOR.

ELECTRICAL (E) NOTES

PANELBOARDS SHALL BE PROVIDED AS MANUFACTURED BY EATON, SQUARE-D, GENERAL ELECTRIC OR APPROVED EQUAL. ALL NEW EQUIPMENT FOR THE PROJECT SHALL BE OF

PANELS SHALL BE FULLY RATED (AIC). NO SERIES AIC RATINGS ARE ALLOWED.

PANELS SHALL HAVE FULL SIZE EQUIPMENT GROUNDING BARS AND NEUTRAL BARS, EXCEPT WHERE INDICATED TO BE 200%.

EP-4 ALL BUSSING, INCLUDING NEUTRAL AND GROUND, SHALL BE COPPER.

ALL BREAKERS SHALL BE AUTOMATIC THERMAL-MAGNETIC TYPE, MOLDED CASE BOLT-ON TYPE, CALIBRATED FOR 40 DEGREE C, OR AMBIENT COMPENSATION, UNLESS OTHERWISE

ALL PANELBOARD AND BREAKER LUGS SHALL BE SIZED AND RATED PER THE CONDUCTOR LIGHTING AND APPLIANCE PANELS (100A TO 600A) SHALL HAVE FRONT ACCESSIBLE HINGED DOOR-IN-DOOR COVERS WITH DEAD FRONT, SHALL BE 20" WIDE MINIMUM WITH 4" WIDE

DISTRIBUTION PANELS (600A TO 1200A) SHALL HAVE FRONT ACCESSIBLE DEAD FRONT

PROVIDE HANDLE LOCK-ON DEVICES FOR ALL CIRCUIT BREAKERS CONNECTED TO EMERGENCY, EXIT, NIGHT LIGHTING, FIRE ALARM, TELEPHONE BOARDS, AND SECURITY

EP-10 BREAKERS USED FOR SWITCHING SHALL BE SWITCHING DUTY (SWD) RATED.

BREAKERS USED FOR HEATING, AIR CONDITIONING AND/OR REFRIGERATION SHALL BE

EP-12 GROUND-FAULT CIRCUIT-INTERRUPTER (GFCI) PROTECTION FOR PERSONNEL SHALL BE PROVIDED IN ALL LOCATIONS PER NEC 210.8. WHERE A DEVICE LOCATION IS NOT ACCESSIBLE, THE GFCI PROTECTION SHALL BE PROVIDED WITH THE BREAKER SERVING

EP-13 BREAKERS WITH ARC-FAULT CIRCUIT-INTERRUPTER (AFCI) PROTECTION SHALL BE INSTALLED FOR ALL 120V, 15A AND 20A BRANCH CIRCUITS IN DWELLING UNITS AS DEFINED BY THE NEC. THIS EXCLUDES KITCHENS, BATHROOMS, UNFINISHED BASEMENTS, GARAGES AND OUTDOOR LOCATIONS. GUEST ROOMS/SUITES WITH PERMANENT PROVISIONS FOR COOKING SHALL BE CONSIDERED A DWELLING UNIT. STUDENT HOUSING UNITS SHALL BE CONSIDERED A DWELLING UNIT.

EP-14 ALL OVERCURRENT DEVICES WHICH COMPRISE THE EMERGENCY SYSTEM SHALL BE SELECTIVELY COORDINATED. THE ELECTRICAL CONTRACTOR SHALL PROVIDE MANUFACTURER DOCUMENTATION INDICATING COMPLIANCE WITH THE SELECTIVE COORDINATION REQUIREMENTS PER THE NEC.

ELECTRICAL (E) NOTES

LIGHTING (EL)

MOUNT ALL FIXTURES PLUMB AND SQUARE WITH ROWS ALIGNED.

EL-2 SEE ARCHITECTURAL REFLECTED CEILING PLANS FOR EXACT LOCATION OF FIXTURES.

ALL FIXTURES SHALL BE UL LISTED AND LABELED.

EL-4 ALL FIXTURES SHALL BE THERMALLY PROTECTED PER THE NEC

SURFACE-MOUNTED FLUORESCENT FIXTURES INSTALLED ON COMBUSTIBLE MATERIAL SHALL BE MOUNTED AT LEAST 1/4" FROM THE SURFACE OF THE MATERIAL, EXCEPT FOR FIXTURES THAT ARE PLAINLY MARKED AS UL APPROVED FOR MOUNTING DIRECTLY TO SUCH SURFACES.

EL-6 ALL FIXTURES SHALL BE GROUNDED PER THE NEC.

FIXTURES CONNECTED WITH FLEX TO THE RIGID RACEWAY PORTION OF THE WIRING SYSTEM SHALL CARRY A GREEN BONDING JUMPER WITHIN THE FLEX. THE JUMPER SHALL BE FASTENED TO BOTH THE FIXTURE AND THE RACEWAY SYSTEM WITH A STEEL CITY "G" CLIP OR APPROVED EQUIVALENT. PHASE AND GROUND CONDUCTORS RUN IN FLEX SHALL BE #12 AWG MINIMUM. MAXIMUM FLEX LENGTH SHALL BE 6'-0".

FLORESCENT LUMINARIES THAT UTILIZE DOUBLE-ENDED LAMPS AND CONTAIN BALLAST(S) THAT CAN BE SERVICED IN PLACE SHALL HAVE A DISCONNECTING MEANS (WHETHER INTEGRAL OR EXTERNAL) TO EACH LUMINAIRE PER NEC 410.130(G).

ALL FIXTURES SHALL BE PROVIDED FOR PROPER VOLTAGE BASED ON THE CIRCUIT ASSIGNMENT INDICATED ON THE PLANS.

FIXTURE/EQUIPMENT SCHEDULES

EL-10 FIXTURE TYPES ARE AS SCHEDULED ON THE PLANS. EQUIVALENT FIXTURES MAY BE SUBMITTED AS INDICATED ON THE FIXTURE SCHEDULE, SUBJECT TO THE ENGINEERS

ALL COST ASSOCIATED WITH SUBSTITUTED FIXTURES TO COMPLY WITH BASIS OF DESIGN INCLUDING PROVIDING TRIM, ACCESS, MOUNTING, LAMPS, ETC., SHALL BE INCLUDED IN THE ORIGINAL BASE BID. NO ADDITIONAL COST ASSOCIATED WITH SUBSTITUTED FIXTURE WILL BE ACCEPTED DURING CONSTRUCTION AND ALL COST WILL BE THE RESPONSIBILITY OF THE ELECTRICAL CONTRACTOR. THIS INCLUDES ANY MODIFICATIONS TO ANY ASSOCIATED MECHANICAL PLUMBING OR FLECTRICAL SYSTEMS REQUIRED BY THIS SPECIFIC MANUFACTURER'S INSTALLATION INSTRUCTIONS.

EL-12 CATALOG NUMBERS ARE FOR GENERAL IDENTIFICATION OF FIXTURES ONLY. ALL RELATED PARTS, SUCH AS JUNCTION BOXES, PLASTER RINGS, LOUVERS, MOUNTING EQUIPMENT, CONNECTORS, STRAPS, OR OTHER HARDWARE OR ACCESSORIES TO FIT THE FIXTURE PROPERLY TO THE STRUCTURE, SHALL BE FURNISHED AND INSTALLED BY THE ELECTRICAL CONTRACTOR. THE CONTRACTOR SHALL PROVIDE ANY APPURTENANCES FOR MOUNTING OR TRIM TO CEILING OR WALL TYPE AS SPECIFIED IN THE ARCHITECTURAL FINISH SCHEDULES REGARDLESS OF THE CATALOG NUMBER GIVEN

EL-13 ALL LIGHTING FIXTURES SHALL COME EQUIPPED WITH LAMPS. ACCEPTABLE LAMP MANUFACTURERS ARE GENERAL ELECTRIC, PHILIPS, OR SYLVANIA UNLESS OTHERWISE NOTED ON THE FIXTURE SCHEDULE.

TIME CONTROLLER. FURNISH AND INSTALL WHERE INDICATED AN ELECTRONIC TIME CONTROLLER AS MANUFACTURED BY TORK (NSI), PARAGON, INTERMATIC, OR APPROVED EQUAL. CONTROLLER SHALL HAVE THE FOLLOWING CHARACTERISTICS:

CONTACTS: SPST, OR AS INDICATED RATED 120/277V AT 20A BALLAST LOAD

MINIMUM 30K SWITCHING CYCLES MINIMUM 2 CHANNELS, AS INDICATED, OR AS REQUIRED TO MEET THE

INTENT OF THE DRAWINGS EACH CHANNEL SHALL BE INDIVIDUALLY PROGRAMMABLE WITH: 128 ON-OFF OPERATIONS PER WEEK

FOUR SEASONAL SCHEDULES TO MODIFY THE BASE PROGRAM A HOLIDAY SCHEDULE THAT OVERRIDES THE WEEKLY OPERATION PHOTOELECTRIC SENSOR

ASTRONOMIC DIAL BATTERY BACKUP

NON-VOLITILE MEMORY FOR SCHEDULES AND TIME CLOCK EL-15 CONTACTORS. LIGHTING CONTACTORS SHALL SWITCH LOADS AT THE VOLTAGE AND AMPERE RATING INDICATED AND SHALL HAVE THE NUMBER OF POLES INDICATED ON THE DRAWINGS, OR AS REQUIRED. THE CONTACTOR AND CONTACTS SHALL BE CONTINUOUSLY

RATED FOR THE LOAD SERVED, INCLUDING TUNGSTEN FILAMENT, INDUCTIVE, AND

HIGH-INRUSH BALLAST LOADS. EL-16 ALL LIGHTING CONTACTORS SHALL BE ELECTRONICALLY HELD AND BE INSTALLED IN A

ELECTRICAL (E) NOTES

ALL CONDUCTORS SHALL BE IN CONDUIT.

NEMA 1 ENCLOSURE, UNLESS OTHERWISE NOTED.

EW-2 ALL CONDUCTORS SHALL BE COPPER, RATED 75 C WET/DRY EXCEPT WHERE OTHERWISE NOTED OR REQUIRED BY U.L. OR OTHER CODES.

CONDUCTORS SHALL BE MANUFACTURED BY SOUTHWIRE (SIMPULL), ENCORE

(SUPERSLICK), UNITED COPPER (SLK), CERRO (SLP), OR APPROVED EQUAL, "PRE-LLIBRICATED" BY THE MANUFACTURER

ALL CONDUCTORS SHALL BE SINGLE INSULATED CONDUCTOR, THHN/THWN-2. SIZES #10 AWG AND SMALLER SHALL BE SOLID. SIZES #8 AWG AND LARGER SHALL BE STRANDED.

BRANCH CIRCUITS SHALL NOT BE SMALLER THAN #12 AWG. CONTROL WIRING MAY BE #14 CONDUCTORS SHALL BE COLOR CODED BLACK/RED/BLUE FOR 120/208 VOLT SYSTEMS AND BROWN/ORANGE/YELLOW FOR 277/480 VOLT SYSTEMS FOR A. B. AND C PHASES. RESPECTIVELY.NEUTRAL SHALL BE WHITE FOR 120/208 VOLT SYSTEMS AND NATURAL GRAY FOR 277/480 VOLT SYSTEMS/. GROUND CONDUCTOR SHALL BE GREEN ON ALL SYSTEMS.

ALL CONDUCTOR SIZES SHALL HAVE COLOR-CODED INSULATION. THE USE OF COLORED TAPE ON LARGER WIRE SIZES SHALL NOT BE ALLOWED. EW-7 INSULATION SHALL BE DUAL RATED TYPE THHN/THWN-2 FOR FEEDERS AND BRANCH CIRCUITS. FIXTURE TAPS SHALL BE #12 THHN/THWN-2 IN FLEX WITH GREEN #12 AWG

GROUNDING CONDUCTOR.

EW-8 WIRING TO LIGHTING FIXTURES SHALL BE AS REQUIRED BY UL LABEL.

EW-9 MULTI-WIRE BRANCH CIRCUITS SHALL NOT BE ALLOWED. JOINTS IN #10 AWG AND SMALLER SHALL BE MADE UP WITH CRIMPED CONNECTORS WITH INSULATING CAPS (NO TAPE) OR WIRENUTS (MAXIMUM OF 3 CONDUCTORS UNDER ANY CONNECTOR OR WIRENUT). LARGER WIRE SHALL USE SPLIT BOLTS OR BOLTED CLAMPS.

EW-11 ALL WIRING LUGS THROUGHOUT THE PROJECT. INCLUDING. BUT NOT LIMITED TO. BREAKERS, PANELBOARD/SWITCHBOARD LUGS, SAFETY SWITCH LUGS, MOTOR STARTER LUGS, TRANSFORMERS LUGS, WIRING DEVICE TERMINALS, AND ALL EQUIPMENT LUGS/TERMINALS SHALL BE RATED FOR USE WITH 75 DEGREE INSULATED CONDUCTORS

AT THEIR 75 DEGREE AMPACITY AND SHALL BE SIZED TO MATCH THE CONDUCTOR SIZE EW-12 CIRCUIT JOINTS SHALL NOT BE MADE ON DEVICE TERMINALS.

NTERVALS AS REQUIRED PER NEC 300-19.

51'-90'

THE ENGINEER.

EW-13 WIRE WITHIN PANEL BOARDS SHALL BE NEATLY TRAINED, SQUARED, BUNCHED, AND

EW-14 ALL SYSTEM FURNITURE CONNECTIONS SHALL COMPLY WITH NEC 605. EW-15 GROUND ALL EQUIPMENT PER NEC ARTICLE 250. BOND WHERE CONDUITS ENTER FNCLOSURES THROUGH CONCENTRIC KNOCKOUTS, ALL FLEX, INCLUDING FIXTURE TAPS. SHALL INCLUDE GREEN GROUNDING CONDUCTOR, #12 AWG MINIMUM. PROVIDE GREEN INSULATED EQUIPMENT GROUNDING CONDUCTOR IN EACH CONDUIT, SIZED PER NEC

EW-16 ALL CONDUCTORS INSTALLED IN VERTICAL RACEWAYS SHALL BE SUPPORTED AT

THE ELECTRICAL CONTRACTOR SHALL FOLLOW AND APPLY THE TABLE BELOW, REGARDLESS OF WHAT THE PANEL SCHEDULE INDICATES, FOR SIZING ALL 120V & 277V, 20 AMP BRANCH CIRCUITS (COPPER CONDUCTORS) TO ALLOW A MAXIMUM OF 3% VOLTAGE DROP FROM THE CIRCUIT BREAKER TO THE FIRST DEVOCE ON THE BRANCH CIRCUIT AND ACHIEVE A MAXIMUM OF 5% VOLTAGE DROP ACROSS THE ENTIRE BRANCH CIRCUIT.

91'-140' 141'-225' * - THE LENGTH IS MEASURED FROM THE CIRCUIT BREAKER TO THE FIRST DEVICE WHICH THE BRANCH CIRCUIT SERVES. WHERE THE DISTANCE EXCEEDS ABOVE, CONSULT WITH

ELECTRICAL (E) NOTES

GENERAL (EG)

THE WORK COVERED BY THESE SPECIFICATIONS CONSISTS OF FURNISHING ALL LABOR, EQUIPMENT, MATERIALS, AND SUPPLIES AS THE WORK COVERED BY THESE SPECIFICATIONS CONSISTS OF FURNISHING ALL LABOR, EQUIPMENT, MATERIALS, AND SUPPLIES AS

NECESSARY FOR THE COMPLETE AND SATISFACTORY OPERATING ELECTRICAL SYSTEMS AS SHOWN ON THE PLANS.

ALL WORK SHALL BE IN ACCORDANCE WITH THE NATIONAL ELECTRICAL CODE, NFPA, STATE BUILDING CODE, AND ANY OTHER LOCAL REQUIREMENTS THAT MAY APPLY. CONTRACTOR SHALL PAY FOR ALL REQUIRED PERMITS, FEES, INSPECTIONS, ETC.

CONTRACTOR SHALL OBTAIN AND PAY FOR ALL ELECTRICAL PERMITS AND INSPECTION FEES.

ALL MATERIALS AND EQUIPMENT SHALL BE NEW AND SHALL BE LISTED BY THE UNDERWRITER'S LABORATORIES, INC. OR BY A STATE APPROVED THIRD PARTY TESTING AGENCY FOR THE USE INTENDED WHERE A STANDARD FOR SUCH MATERIALS AND USE EXISTS. ALL ITEMS OF THE SAME TYPE AND RATING SHALL BE IDENTICAL AND OF THE SAME MANUFACTURER.

CONTRACTOR SHALL SUBMIT SHOP DRAWINGS AND CATALOG DATA IN ELECTRONIC FORMAT (PDF) FOR ALL ELECTRICAL ITEMS IN THE SCOPE OF WORK, INCLUDING, BUT NOT LIMITED TO, RACEWAYS, BOXES, FITTINGS, CONDUCTORS, LUMINAIRES, LAMPS, BALLASTS, WIRING DEVICES, SAFETY SWITCHES, DISCONNECTS, TRANSFORMERS, PANELBOARDS, FIRE ALARM, TELECOMMUNICATIONS, ETC. FOR APPROVAL AS APPLICABLE FOR THE PROJECT. ONE COMPLETE SET OF APPROVED SUBMITTALS SHALL BE MAINTAINED AT THE JOB SITE.

ALL COST ASSOCIATED WITH SUBSTITUTED EQUIPMENT TO COMPLY WITH THE BASIS OF DESIGN, INCLUDING PROVIDING MAINTENANCE ACCESS, CLEARANCE, CONDUIT, WIRING, REPLACEMENT OF OTHER SYSTEM COMPONENTS, BUILDING ALTERATIONS, METHODS, ETC., SHALL BE INCLUDED IN THE ORIGINAL BASE BID. NO ADDITIONAL COSTS ASSOCIATE WITH SUBSTITUTED EQUIPMENT WILL BE APPROVED AFTER BIDS HAVE BEEN ACCEPTED AND ALL COSTS WILL BE THE RESPONSIBILITY OF THE ELECTRICAL CONTRACTOR. CREDITS SHALL BE GIVEN TO THE OWNER WHERE SUCH EQUIPMENT AND METHODS RESULT IN LESS EXPENSE TO THE CONTRACTOR.

ONE COMPLETE SET OF THE LATEST CONSTRUCTION PLANS OF ALL TRADES SHALL BE MAINTAINED AT THE JOB SITE. IN ADDITION, ALL ADDENDUMS, BULLETINS, AND/OR SKETCHES SHALL BE INCORPORATED INTO THE ON-SITE CONSTRUCTION PLANS AS THE JOB

COMPLETE ADEQUATE HOUSING SHALL BE PROVIDED FOR ALL MATERIALS STORED ON JOB SITE. ONLY CONDUIT MAY BE STORED OUTSIDE, BUT NOT IN CONTACT WITH THE GROUND.

THE CONDUIT AND NEUTRAL SYSTEM SHALL BE GROUNDED AT THE MAIN SERVICE EQUIPMENT. GROUNDING ELECTRODE SYSTEM SHALL

EG-10 PROVIDE AN INTERSYSTEM BONDING TERMINATION DEVICE AT THE MAIN ELECTRICAL SERVICE PER NEC 250.94. WIRING SHALL BE TESTED FOR CONTINUITY AND GROUNDS BEFORE BEING ENERGIZED. FAULTY WIRING SHALL BE REPLACED AT NO

ADDITIONAL EXPENSE TO THE OWNER. EG-12 PROVIDE ALL CUTTING AND PATCHING FOR INSTALLATION OF WORK AND REPAIR ANY DAMAGE.

EG-13. THE ELECTRICAL CONTRACTOR SHALL CONNECT ALL EQUIPMENT REQUIRING ELECTRICAL CONNECTIONS (UNLESS OTHERWISE NOTED), EXCEPT FOR CONTROL WIRING FOR EQUIPMENT NOT PROVIDED BY THE ELECTRICAL CONTRACTOR. CONTROL WIRING FOR SUCH EQUIPMENT SHALL BE PROVIDED BY THE RESPECTIVE DISCIPI INF.

EG-14. ALL ELECTRICAL JUNCTION BOXES, SWITCHGEAR, CABLING, VOICE/DATA OUTLETS, LOW VOLTAGE CABINETS, EMERGENCY RECEPTACLES, ETC. SHALL BE LABELED ACCORDING TO PANEL/RACK AND CIRCUIT NUMBER.

EG-15 UPON COMPLETION OF WORK, CONTRACTOR SHALL PRESENT ENGINEER WITH CERTIFICATE OF APPROVAL FROM LOCAL INSPECTOR

AND/OR AUTHORITY HAVING JURISDICTION BEFORE WORK WILL BE APPROVED FOR FINAL PAYMENT. EG-16 CONTRACTOR SHALL GUARANTEE ALL WORK AND MATERIALS FOR A PERIOD OF ONE YEAR EFFECTIVE THE DATE THE PROJECT IS ACCEPTED BY THE OWNER. ANY IMPERFECT MATERIALS OR WORKMANSHIP SHALL BE REPLACED WITHOUT ADDED COST TO THE PROJECT.

EG-17 IT IS NOT THE INTENT OF ISSUED PLANS AND/OR SPECIFICATIONS TO SHOW EVERY MINOR DETAIL OF CONSTRUCTION. THE ELECTRICAL CONTRACTOR IS EXPECTED TO FURNISH AND INSTALL ALL NECESSARY ITEMS FOR A COMPLETE AND OPERATING SYSTEM. EG-18 THE WORD "PROVIDE" MEANS THAT THIS CONTRACTOR SHALL FURNISH, FABRICATE, ERECT, CONNECT, AND COMPLETELY INSTALL SYSTEMS IN PROPER OPERATING CONDITION. ALL LABOR, PRODUCT OPTIONS, ACCESSORIES AND INCIDENTAL MATERIALS REQUIRED

SHALL BE INCLUDED AS PART OF THIS WORK TO COMPLETE THE INSTALLATION. EG-19 THE WORD "CONNECT" MEANS THAT THIS CONTRACTOR SHALL PROVIDE (SEE DEFINITION ABOVE) ALL DISCONNECTING MEANS, OVERCURRENT PROTECTION AND WIRING REQUIRED TO PLACE THE EQUIPMENT AND SYSTEMS IN PROPER OPERATING CONDITION AND TO

EG-20 CONTRACTOR SHALL COORDINATE THE ROUGH-IN OF ALL OUTLET LOCATIONS WITH ARCHITECTURAL FLOOR PLANS, ELEVATIONS, AND MILLWORK SHOP DRAWINGS PRIOR TO ROUGH-IN.

EG-21 ELECTRICAL CONTRACTOR SHALL NOT SCALE PLANS. CONTRACTOR SHALL REFER TO ARCHITECTURAL FLOOR PLANS AND ELEVATIONS

FOR EXACT LOCATIONS OF ALL EQUIPMENT, UNLESS OTHERWISE NOTED. EG-22 CONTRACTOR SHALL TEST ALL "LIFE SAFETY" EQUIPMENT AND SYSTEMS FOR PROPER FUNCTION AND OPERATION. UPON SUCCESSFUL COMPLETION OF TESTS, CONFIRMATION SHALL BE SENT TO THE ENGINEER OF RECORD IN THE FORM OF A LETTER STATING THE TESTS PERFORMED, THE RESULTS, AND THE DATE TESTS WERE SUCCESSFULLY COMPLETE. "LIFE SAFETY" EQUIPMENT AND SYSTEMS CONSIST OF THOSE AS SPECIFIED IN THE STATE BUILDING CODE, THE NATIONAL ELECTRICAL CODE (NEC), NFPA 101, AND ANY OTHER LOCAL

EG-23 IF DURING THE COURSE OF WORK, THE CONTRACTOR DISCOVERS A PROBLEM WITH THE PERFORMANCE OF THE INSTALLATION RELATIVE TO THE PLANS AND SPECIFICATIONS, THE NEC, OR OTHER CODES OR REQUIREMENTS, THE CONTRACTOR SHALL IMMEDIATELY BRING THE PROBLEM TO THE ATTENTION OF THE ARCHITECT AND/OR ENGINEER FOR RESOLUTION PRIOR TO THE EXECUTION OF THE WORK. EG-24 WHERE THERE ARE CONFLICTS BETWEEN THE PLANS AND SPECIFICATIONS, THE CONTRACTOR SHALL BRING THE ISSUE TO THE ATTENTION

OF THE ENGINEER FOR RESOLUTION PRIOR TO THE EXECUTION OF THE WORK OR ORDERING ANY MATERIALS. NO ADDITIONAL COSTS SHALL BE WARRANTED WITHOUT A CHANGE TO THE PROJECT SCOPE.

REQUIREMENTS THAT MAY APPLY.

EG-25 NAILS OR POWDER ACTUATED FASTENERS SHALL NOT BE USED.

EG-26 EMT/IMC/RGS SUPPORTS SHALL BE A MAXIMUM OF 8'-0" APART AND A MINIMUM OF 3'-0" FROM BOXES. LIGHTING FIXTURES MOUNTED IN OR ON CEILINGS SHALL BE SUPPORTED FROM STRUCTURE VIA 12 GAUGE STEEL WIRE. PROVIDE A MINIMUM OF FOUR WIRES, ONE ATTACHED TO EACH CORNER OF LAY-IN FIXTURES. RECESSED DOWNLIGHT FIXTURES SHALL BE SUPPORTED THE SAME. DO NOT SUPPORT RACEWAY OR FIXTURES FROM CEILING OR DUCT WORK, USE U.L. LISTED GRID CLIPS ON ALL

ALL EQUIPMENT SHALL BE ADEQUATELY SUPPORTED FROM STRUCTURE.

EG-29 NAILS OR POWDER ACTUATED FASTENERS SHALL NOT BE USED.

EG-30 EMT/IMC/RGS SUPPORTS SHALL BE A MAXIMUM OF 8'-0" APART AND A MINIMUM OF 3'-0" FROM BOXES. EG-31 LIGHTING FIXTURES MOUNTED IN OR ON CEILING SHALL BE SUPPORTED FROM STRUCTURE VIA 12 GAUGE STEEL WIRE. PROVIDE A MINIMUM OF FOUR WIRES. ONE ATTACHED TO EACH CORNER OF LAY-IN FIXTURES. RECESSED DOWNLIGHT FIXTURES SHALL BE SUPPORTED THE SAME. DO NOT SUPPORT RACEWAY OR FIXTURES FROM CEILING OR DUCT WORK. USE U.L. LISTED GRID CLIPS ON ALL

SUITABLE FINISH COAT SHALL BE PROVIDED FOR ALL EQUIPMENT, PANEL TUBS, COVERS, ETC, SHALL BE PRIMED AND ENAMELED TO BLEND WITH ADJACENT SURFACES, OR SHALL BE MANUFACTURER'S STANDARD COLOR BAKED ENAMEL FINISH, OR AS DIRECTED BY THE

PROVIDE ENGRAVED PHENOLIC NAMEPLATES FOR ALL ELECTRICAL EQUIPMENT SUPPLIED FOR THE PROJECT, INCLUDING BUT NOT LIMITED TO, WIRING TROUGHS, SAFETY SWITCHES, DISCONNECTS, TRANSFORMERS, PANELBOARDS, ETC. PROVIDE NAMEPLATES FOR CIRCUIT BREAKERS IN SWITCHGEARS, SWITCHBOARDS AND DISTRIBUTION PANELS.

EACH NAMEPLATE SHALL INDICATE THE FOLLOWING:

SYSTEM VOLTAGE (VOLTAGE/PHASE/WIRE) 3. UPSTREAM DEVICE & CIRCUIT

DEVICE NAME

NAMEPLATE COLORS SHALL BE AS FOLLOWS: 277/480V EQUIPMENT BLACK WHITE **EMERGENCY BRIGHT RED** WHITE FIRE ALARM SECURITY BURGUNDY

ORANGE

RROWN

PURPLE WHITE BLACK PAGING WHITE PLATE THICKNESS NAMEPLATES UP TO 8 SQUARE INCHES = NOT LESS THAN 1/16" THICK

NAMEPLATES OVER 8 SQUARE INCHES = NOT LESS THAN 1/8' THICK LETTERING HEIGHT = 1/2" MINIMUM

TELEPHONE

DATA

NAMEPLATES SHALL BE ATTACHED WITH SELF-DRILLING / SELF-TAPPING SCREWS, EXCEPT RIVETS SHALL BE USED WHERE THE END OF SCREW IS NOT PROTECTED

WHITE

WHITE

UP TO 5 SQUARE INCHES = 2 SCREWS 5 TO 12 SQUARE INCHES = 4 SCREWS OVER 12 SQUARE INCHES = 6 SCREWS

MINIMUM NUMBER OF SCREWS;

ELECTRICAL SPECIFICATIONS:

FIRE ALARM SYSTEM:

A. SYSTEM SHALL BE A CENTRALIZED, ANALOG, ADDRESSABLE, FULLY ELECTRONICALLY SUPERVISED (INCLUDING AUXILIARY SYSTEMS INTERCONNECT) WIRING) SYSTEM LISTED BY UL IN COMPLIANCE WITH ALL APPLICABLE NFPA 72 AND OTHER STANDARDS AS WELL AS THE AMERICAN'S WITH DISABILITIES ACT (ADA), ALL FINAL CONNECTIONS, TESTING AND ADJUSTMENTS SHALL BE PERFORMED BY OR UNDER DIRECT SUPERVISION OF AN AUTHORIZED FACTORY REPRESENTATIVE. SYSTEM SHALL BE SIMPLEX, NOTIFIER, SIEMENS, OR APPROVED EQUAL AS ACCEPTED BY THE ENGINEER. SYSTEM SHALL HAVE A24 HR MINIMUM

BATTERY BACKUP INITIATION DEVICE ACTIVATION SHALL CAUSE OPERATION OF THE PROPER ALARM CIRCUIT IN THE CONTROL PANEL, AND OPERATE ALL AUDIBLE AND VISUAL INDICATION ALARMS. ALL AIR HANDLING UNITS SHALL BE STOPPED UPON ANY ALARM INPUT. EACH AIR HANDLER UNIT SHALL BE PROVIDED WITH A SYSTEM CONTROLLED RELAY TO EFFECT SHUTDOWN, ALL ALARM DEVICES AND LAMPS SHALL CONTINUE TO OPERATE UNTIL THE INITIATING DEVICE IS RESET. SUBSEQUENT ALARMS SHALL RESOUND THE SYSTEM. AN AUDIBLE AND VISUAL SIGNAL SHALL INDICATE SYSTEM TROUBLE. THE CONTROL PANEL SHALL PROVIDE FOR ACTIVATING A UL LISTED CENTRAL STATION SIGNAL FOR NOTIFYING THE FIRE

DEPARTMENT MANUAL STATIONS SHALL BE NON-CODED, WITH PULL LEVER AND GLASS ROD, SEMI-FLUSH MOUNTED. COMBINATION LIGHT AND HORN SIGNALS SHALL BE FLUSHED MOUNTED, WIRING SHALL BE IN CONDUIT AS PREVIOUSLY SPECIFIED, #14 AWG MINIMUM, THHN. ALL J-BOXES USED FOR THE FIRE ALARM SYSTEM SHALL BE PAINTED RED

CONDUCTORS SHALL BE PLENUM-RATED ND INSTALLED IN CONDUIT AND INSTALLED IN COMPLIANCE WITH NFPA 70, ARTICLE 760; IN ADDITION TO WIRING

METHODS 300.4. ALL FIRE ALARM WIRING SHALL BE CLASS B. PROVIDE ALL REQUIRED MODULES, POWER EXTENDERS, PROGRAMMING, ETC. FOR

A COMPLETE AND OPERATIONAL SYSTEM. SUBMIT FIRE ALARM SHOP DRAWINGS CONSISTING OF PRODUCT DATA, TO THE

ENGINEER AND FOR APPROVAL

THE OWNER NOTIFYING THE CONTRACTOR.

ELECTRICAL COORDINATION WITH OTHER TRADES:

FILL OUT NFPA 72 CERTIFICATION REPORT AND SUBMIT TO ENGINEER AND AUTHORITY HAVING JURISDICTION. WARRANTY - ALL WORK PERFORMED AND ALL MATERIALS AND EQUIPMEN FURNISHED UNDER THIS CONTRACT SHALL BE FREE FROM DEFECTS AND SHALL REMAIN SO FOR A PERIOD OF AT LEAST TWO (2) YEARS FROM THE DATE OF ACCEPTANCE BY THE PROFESSIONAL ENGINEER AND/OR OWNER. THE FULL COST OF MAINTENANCE, LABOR, AND MATERIALS REQUIRED TO CORRECT ANY DEFECT DURING THIS TWO YEAR PERIOD SHALL BE IMMEDIATELY CORRECTED AT NO ADDITIONAL COST TO THE OWNER. ANY DEFECTS THAT RENDER THE SYSTEM INOPERATIVE SHALL BE REPAIRED WITHIN 24 HOURS OF THE OWNER NOTIFYING

MATERIALS MEETING ASTM E-814. PROVIDE FIRE STOPPING DEVICES(S) OR SYSTEM(S) WHICH HAVE BEEN TESTED AND LISTED AS COMPLYING WITH ASTM E-814. INSTALL THE DEVICE(S) OR SYSTEM(S) IN ACCORDANCE WITH THE CONDITIONS OF THEIR LISTING. PROVIDE THE APPROPRIATE DEVICE(S) OR SYSTEM(S) WITH AN 'F' RATING EQUAL TO THE

RATING OF THE ASSEMBLY BEING PENETRATED. DEVICES(S) AND/OR SYSTEM(S) SHALL BE BY HILTI, 3M OR EQUIVALENT.

THE ELECTRICAL CONTRACTOR SHALL BE FULLY RESPONSIBLE FOR PROVIDING

SEISMIC SUPPORT AND BRACING OF ELECTRICAL COMPONENTS TO RESIST THE EFFECTS OF EARTHQUAKES ON THE ELECTRICAL SYSTEM AS WELL AS ANY AS REQUIRED. THE SEISMIC RESTRAINTS AND SPECIAL INSPECTION SHALL MEET ALL APPLICABLE STATE AND LOCAL BUILDING CODE REQUIREMENTS AS WELL AS ASCE-7 REQUIREMENTS.

PROJECT INCLUDING BUT NOT LIMIT TO MECHANICAL PLUMBING, FIRE PROTECTION AND SUPPRESSION, OWNER FURNISHED, KITCHEN, LABORATORY, ETC. LINEESS OTHERWISE NOTED. THE ELECTRICAL CONTRACTOR SHALL COORDINATE ALL CONNECTIONS PRIOR TO

THE ELECTRICAL C CONTRACTOR SHALL PROVIDE AND INSTALL ALL MANUAL MOTOR

CONTRACTOR.

PROTECTION ON THE BREAKER SUPPLYING THE HEAT TAPE.

FIXTURE LOCATION S ABOVE THE CEILING WITH OTHER TRADES PRIOR TO INSTALLATION. ALL DUCT SMOKE DETECTORS SHALL BE PROVIDED AND CONNECTED BY THE

INSTALLED CORRECTLY AT THE EXPENSE OF THE FLECTRICAL CONTRACTOR

ALL PENETRATIONS OF RATED ASSEMBLIES SHALL BE SEALED WITH RATED

THE CONTRACTOR, OTHER DEFECTS SHALL BE REPAIRED WITHIN 48 HOURS OF

ALIGNED ENGINEERING No. 5025

THE ELECTRICAL CONTRACTOR SHALL CONNECT AND /OR PROVIDE FINAL CONNECTIONS TO ALL EQUIPMENT SUPPLIED BY OTHERS APPLICABLE TO THE ROUGH-IN USING APPROVED CATALOG SHEETS AND SHOP DRAWINGS.

STARTER SWITCHES, DISCONNECT SWITCHES, RECEPTACLES, ETC. TO MECHANICAL AND PLUMBING EQUIPMENT. ALL STARTERS, OTHER THAN MANUAL STARTER SWITCHES, SHALL BE PROVIDED BY OTHERS, BUT INSTALLED BY THE ELECTRICAL ALL DISCONNECT SWITCHES AND FUSE SIZES SHALL BE COORDINATED WITH SHOP DRAWINGS PRIOR TO ORDERING TOR INSTALLING. ANY EQUIPMENT INSTALLED INCORRECTLY BECAUSE OF LACK OF COORDINATION WILL BE REMOVED AND

> ELECTRICAL CONTRACTOR, BUT INSTALLED BY THE MECHANICAL CONTRACTOR. THE ELECTRICAL CONTRACTOR SHALL PROVIDE ALL NECESSARY OUTLETS FOR HEAT TAPE CONNECTIONS FOR MECHANICAL SYSTEMS. PROVIDE CLASS B (30MA) GFCI

THE ELECTRICAL CONTRACTOR SHALL COORDINATE ALL CONDUIT RUNS AND LIGHT

ELECTRICAL

DESIG Jul 21, 201 AE05

MARLEY ENGINEERED PRODUCTS (OR EQUAL) 1500W-115V-IPH-12.5 AMPS CATALOG #AW1+3150F WITH RECESS MOUNT PART #SWHS2 NOTES MARLEY ENGINEERED PRODUCTS (OR EQUAL) 1500W-115V-IPH-12.5 AMPS CATALOG #AW1+3150F WITH SURFACE MOUNT, SHALL BE PART #SWHSM

			LIGH.	T FIXTURE SCHEDULE			
SYMBOL	DESCRIPTION	LAMP DESCRIPTION	TOTAL FIXTURE WATTAGE	BALLASTS	VOLTAGE	MANUFACTURER/CATALOG NUMBER	SPECIFICS
HB1	FLUORESCENT HIGH BAY	4-LSF54/50W/835/HO/SS/ECO	216W	SYLVANIA QUICKTRONIC 2-QHE2X54T5HO/UNV PSN-HT	UNIV	METALUX HBI451T5M—WGUNV—UPL—FH1	WHITE FINISH, SPECULAR REFLECTOR, WIRE GUARD MOUNTED WITH HOOK AND SEISMIC SUPPORT CABLES. MINIMUM 8% UPLIGHT, SURFACE MOUNT
OA	WALLPACK	MCP70/U/MED/830PB	77W	QTP1X70MH/UNV PULSE START METAL HALIDE	UNIV	LITHONIA TWP-70M-120-DWH-LP1-PE	DIECAST ALUMINUM HOUSING. DARK BRONZE FINISH. CLEAR TEMPERED GLASS LENS. WET LOCATION LABEL. COORDINATE HEIGHT WITH ARCHITECTURAL ELEVATIONS.
ОВ	GROUND MOUNTED FLOODLIGHT	MCP70/U/MED/830PB	77W	QTP1X70MH/UNV PULSE START METAL HALIDE	UNIV	LITHONIA ASF1-70M-MDF-120-PE DDBT-LPI	HORIZONTAL FLOOD SPREAD. ONE PIECE DIECAST ALUMINUM HOUSING WITH A CONTINUOUS CYLINDER SHAPE. 3/16" CLEAR TEMPERED GLASS LENS. SEMI-GLOSS BAKED ENAMEL DARK BRONZE FINISH. MOUNT ON A STANCHION IN A 12"X12"X6" DEEP CONCRETE PAD. (FLAG POLE) WALL MOUNT ON 12" EXTENDER ARM FROM BUILDING FRONT (SIGN).
ос	LED EXTERIOR EMERGENCY EGRESS LIGHT	5.4W INCANDESCENT LAMP	11W	NONE	UNIV	CHLORIDE SYSTEMS VW2RHP LITHONIA ELAT6CSWPM12	WHITE POLYCARBONATE HOUSING. WET LOCATION LABEL. MOUNT AT 8' ABOVE FINISHED GRADE. SUPPLY WITH EMERGENCY BATTERY PACK FOR 90 MINUTE OPERATION. BATTERY PACK SHALL BE COLD WEATHER RATED.
x	LED EXIT SIGN	LED	2.5W/FACE	NONE	UNIV	CHLORIDE SYSTEMS SYMMETRY SERIES #SN1RW LITHONIA LQM SW3 120/277 ELN	POLYCARBONATE HOUSING WITH SELF—CONTAINED POWER PACK FOR 90 MINUTES OPERATION. NICAD BATTER. WHITE HOUSING. RED LETTERS.
EL	EMERGENCY LIGHT	2-20W MR16 FLOOD	40W	NONE	UNIV	CHLORIDE SYSTEMS #S250NH20FW LITHONIA ELMLT W LP06V5	POLYCARBONATE HOUSING WITH SELF-CONTAINED POWER PACK FOR 90 MINUTES OPERATION. NICAD BATTER. WHITE HOUSING.
В	FLUSH MOUNT CEILING FIXTURE	CIRCLINE T9	40W	120V 60HZ ELECTRONIC BALLAST	UNIV	LITHONIA FM72 ACLS LP R4	LOW PROFILE FLUSH MOUNT 20" SQUARE, WHITE FINISH, ACRYLIC DIFFUSER.

LIGHT FIXTURE NOTES

- 1. LIGHTING FIXTURES, AS SPECIFIED, HAVE BEEN SELECTED TO ACHIEVE REQUIRED/DESIRED FOOT CANDLE LEVELS OF ILLUMINATION IN THEIR RESPECTIVE AREA, HENCE SPECIFIC FIXTURE CHARACTERISTICS WHICH MAY CREATE PARTICULAR ILLUMINATION RESULTS ARE ESSENTIAL ANY DEVIATIONS FROM SPECIFIED FIXTURES SHALL DEEM THE SUBMITTING AGENT AND CONTRACTOR RESPONSIBLE IN PROVING SUCH DEVIATION WILL PROVIDE THE EXACT LIGHTING RESULT IN DUPLICATION TO THE DESIGN HEREIN.
- 2. SUBSTITUTIONS APPROVED BY THE ENGINEER PREVIOUS TO BID ARE ACCEPTABLE AS LONG AS THEY ARE EQUAL TO SPECIFIED. THIS INCLUDES LENS, COLORS, REFLECTORS, PHOTOMETRIC, HOUSING MATERIALS, FINISHES, ETC. ANY SUBSTITUTIONS SHALL BE SUBMITTED TO THE ENGINEER WITH COMPLETE CUT SHEETS FOR APPROVAL 10 WORKING DAYS PRIOR TO BID. SUBSTITUTE FIXTURES SHALL BE PRICED WITH THE SPECIFIED FIXTURE AND LISTED SEPARATELY FOR THE ENGINEER AND OWNER TO MAKE AN INFORMED DECISION.
- 3. CONTRACTOR SHALL PROVIDE SUITABLE TRIM AND APPURTENANCES TO MOUNT FIXTURES IN TYPE OF CEILING OR WALL AS SPECIFIED IN ARCHITECTURAL FINISH SCHEDULES REGARDLESS OF CATALOG NUMBER GIVEN. CONTRACTOR SHALL VERIFY TYPE OF CEILING OR WALL BY REVIEWING ARCHITECTURAL FINISH SCHEDULES PRIOR TO ORDERING
- 4. ALL 3 AND 4 LAMP RECESSED TROFFER TYPE FIXTURES SHALL BE EQUIPPED WITH MORE THAN ONE BALLAST TO ALLOW FOR SEPARATE SWITCHING OF INBOARD AND OUTBOARD LAMPS WITHIN THE SAME FIXTURE. TANDEM WIRING BETWEEN FIXTURES IS ALLOWED TO ACCOMPLISH THE SAME RESULT. TANDEM WIRING MAY ALSO BE USED TO CONTROL A SINGLE LAMP IN A TWO LAMP FIXTURE WHERE MULT-LEVEL CONTROLS ARE ASSOCIATED WITH 2 LAMP FIXTURES.
- 5. CONFIRM FINAL FIXTURE LOCATION WITH ARCHITECTURAL REFLECTED CEILING PLANS AND ELEVATIONS.
- 6. ELECTRONIC BALLAST FOR T5 LAMPS SHALL HAVE END OF LIFE SHUTDOWN CAPABILITY AS STATED IN SPECIFICATIONS.
- 7. PROVIDE LOW TEMPERATURE (0° F) BALLAST FOR ANY FIXTURE INSTALLED ON EXTERIOR OR OTHER AREAS SUBJECT TO LOW TEMPERATURES.
- 8. FLUORESCENT FIXTURES EQUIPPED WITH EMERGENCY BATTERY PACKS SHALL BE SUPPLIED WITH 1100 LUMEN INVERTERS AND DUAL INPUT TYPE INVERTERS WHERE SO INDICATED ON PLANS AND FED AHEAD OF SWITCHED CIRCUITS FOR THAT DESIGNATED AREA. EMERGENCY BALLAST SHALL BE INSTALLED BY THE FIXTURE MANUFACTURER.
- 9. FLUORESCENT BALLAST THAT CAN BE SERVICED IN PLACE WALL HAVE A DISCONNECT MEANS COMPLIANT WITH NEC 410.130G.
- 10. DURING THE BIDDING PROCESS, THE CONTRACTOR SHALL INFORM ARCHITECT AND ENGINEER OF ANY DELIVERY OR SCHEDULING ISSUES THAT MAY IMPACT THE PROJECT CRITICAL PATH SCHEDULING.
- 11. NO FIXTURE SUBSTITUTIONS WILL BE CONSIDERED DUE TO LACK OF COORDINATION OF DELIVERY DATES AND CONSTRUCTION SCHEDULE AFTER TIME OF BID.
- 12. ALL MATERIAL EXPEDITING EXPENSES SHALL BE THE RESPONSIBILITY OF THE CONTRACTOR.
- 13. ANY FIXTURES BEING BEING INSTALLED IN CEILING, INDICATED BY THE ARCHITECT AS HAVING INSULATION IN CONTACT WITH THE CEILING SURFACE, SHALL BE IC RATED AND LABELED SUCH FROM THE MANUFACTURER.
- 14. ACCEPTABLE BALLAST MANUFACTURERS FOR SUBMISSION ARE ARE OSRAM/SYLVANIA, ADVANCE, GE, PHILLIPS OR UNIVERSAL TRIAD PROVIDED THEY MEET INTENDED CRITERIA AS LISTED IN THIS SCHEDULE AND PROJECT
- 15. ALL FIXTURES SHALL BE MADE IN AMERICA IN AS MUCH AS POSSIBLE.

WATTAGE IN THAT FIXTURE.

- 16. ALL INCANDESCENT LIGHT FIXTURES SHALL BEAR A U.L. LABEL INDICATING THE MAXIMUM ALLOWABLE LAMP
- 17. INSTALL ALL FLUORESCENT DOWN-LIGHT FIXTURES SO THAT ALL LAMPS ARE ALIGNED IN THE SAME DIRECTION.
- 18. SUPPORT RECESSED TROFFERS AT ALL FOUR CORNERS FROM STRUCTURE.
- 19. ALL METAL HALIDE LAMPS AND BALLAST SHALL MEET OR EXCEED THE ENERGY INDEPENDENCE AND SECURITY ACT 2001 (EISA) REQUIREMENTS.
- 20. FLUORESCENT LAMP AND BALLAST WARRANTY SHALL BE COMPLETED BY THE ELECTRICAL CONTRACTOR AND SUBMITTED WITH A COPY TO THE OWNER UPON PROJECT CLOSE OUT.
- 21. ALL LINEAR FLUORESCENT LAMPS SHALL BE 3500K UNLESS OTHERWISE INDICATED ON SCHEDULE.
- 22. ALL LED SITE LIGHTING FIXTURES SHALL HAVE SURGE PROTECTION BUILT IN INTEGRAL TO THE FIXTURE.
- 23. ALL ELECTRONIC BALLAST SERVING LINEAR FLUORESCENT LAMPS SHALL BE PROGRAM START.
- 24. COMPLETELY EXAMINE LIGHTING PLANS TO COORDINATE SWITCHING, DIMMING AND ANY SPECIAL BALLAST CONTROLS THAT MAY BE PART OF THE DESIGN INTENT.
- 25. EMERGENCY EGRESS FIXTURES SHALL BE IDENTIFIED WITH A 2" DIAMETER RED DOT ON FRAME, VISIBLE FROM THE
- 26. COORDINATE CLOSELY FIXTURES CONTROLLED VIA AUTOMATIC OR DIMMING CONTROLS TO ASSURE FIXTURE APPENDAGES ARE ORDERED PROPERLY TO MEET DESIGN INTENT.
- 27. CONTRACTOR SHALL FURNISH A COMPLETE SET OF PLANS TO HIS SUPPLIER TO ASSURE LIGHTING PACKAGE IS COMPLETE.
- 28. ELECTRICAL VALUE ENGINEERING SHALL BE BILLED AT AN HOURLY RATE BY ENGINEERING BEFORE SUBMITTAL REVIEWS.
- 29. EMERGENCY BALLASTS FOR LED FIXTURES MOUNTED IN UNCONDITIONED SPACES SHALL BE BODINE 'BSL10' SERIERS OR EQUAL.

LIGHTING (SEE FIXTURE SCH.) ORESCENT OR LED LIGHTING FIXTURE. SEE FIXTURE SCHEDU

FLUORESCENT OR LED LIGHTING FIXTURE. SEE FIXTURE SCHEDULE. SUSPEND FOUR CORNERS WITH WIRE TO STRUCTURE. DO NOT ALLOW GRID ALONE TO SUPPORT FIXTURE.

O FLUOR., LED OR H.I.D. LIGHTING FIXTURE.

WALL MOUNTED INCANDESCENT, FLUOR, LED OR H.I.D. LIGHTING FIXTURE.

FLUORESCENT FIXTURE WITH EMERGENCY BATTERY PACK. 1100 LUMEN INVERTER

EXIT LIGHT WITH ARROWS AND NUMBERS OF FACES AS INDICATED ON PLANS. 90 MIN. BATTERY BACKUP

PEMERGENCY BATTERY PACK FIXTURE. 90 MIN. BATTERY BACK UP

EMERGENCY BATTERY PACK/EXIT COMBO FIXTURE 90 MIN. BATTERY BACK UP

EXTERIOR EMERGENCY FIXTURE. 90 MIN. BATTERY BACK UP

FLOODLIGHT

SINGLE POLE SWITCH, 20 AMP, 120/277 VOLT, COOPER 1221, OR EQUAL.

THREE WAY SWITCH, 20 AMP, 120/277 VOLT, COOPER 1223, OR EQUAL.

INFRARED TECHNOLOGY, SENSOR SWITCH WSX PDT 2P 2VA OR EQUAL

© CEILING MOUNTED VACANCY SENSOR, DUAL TECHNOLOGY. WATT STOPPER DT-300 OR EQUAL W/BZ SERIES POWER PACK


WALL MOUNTED OCCUPANCY SENSOR AND SWITCH.
INFRARED TECHNOLOGY, SENSOR SWITCH WSX PDT 2P 2VA OR EQUAL

S_{VS} WALL MOUNTED VACANCY SENSOR AND SWITCH.

· · · · · · · · · · · · · · · · · · ·	SU		120/2	L A: FLE 40VAC * 1 * INDOOR MAIN LU	PHASE * 3	3 WIRE		IJТ	
POWER				PHASE L	OADING				LIGHTING
DESCRIPTION	WIRE	BRKR	СКТ#	Α	В	скт#	BRKR	WIRE	DESCRIPTION
RESERVED (WELL BUILDING)	N/A	15	1	462		2	15	#8	EXTERIOR BUILDING LIGHTS
WELL PUMP	#6	25	3		3078	4	15	#10	HIGH BAY 1 & REST ROOM
WATER HEATER	#10	15	5	2400		6	15	#8	HIGH BAY 2
RECEPTACLES	#8	15	7		2460	8	15	#8	HIGH BAY 3
RECEPTACLES	#8	15	9	1671	andria de la compania de la compania La compania de la compania della compania de	10	15	#8	EXTERIOR FLOOD LIGHTS
IFH-1 (INFRARED HEATING UNIT)	#10	15	11		866	12	15	N/A	FUTURE
EXHAUST FAN FH-1	#8	20	13	1749		14	15	#10	ELECTRIC WALL HEATER EWH-1
INTAKE FAN FH-2	#10	20	15		249	16	15	N/A	RESERVED
FUTURE	N/A	15	17	1500		18	15	#10	ELECTRIC WALL HEATER EWH-2
FUTURE	N/A	15	19		360	20	~15	#10	SHORE POWER
BAY DOOR MOTOR 1	#8	15	21	375		22	15	N/A	FUTURE
BAY DOOR MOTOR 2	#8	15	23	egyppysia e segregours To	375	24	15	N/A	FUTURE
				8.2	7.4	TOTAL	LOAD IN	KWAT	rs per phase
		68.0	TOTAL LOAD IN AMPS PER PHASE						
					9.5 RATING = :		AMPERA	AGE LOA	AD



and the same and the

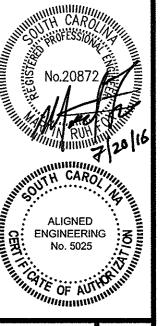



STATION AT FRIENDFIELD


SCRIPTION:
ELECTRICAL
NOTES &
SCHEDULES


PLAN SET: DESIGN

DATE: Jul 21, 2016

PROJECT: AE055

SHEET: E2.0

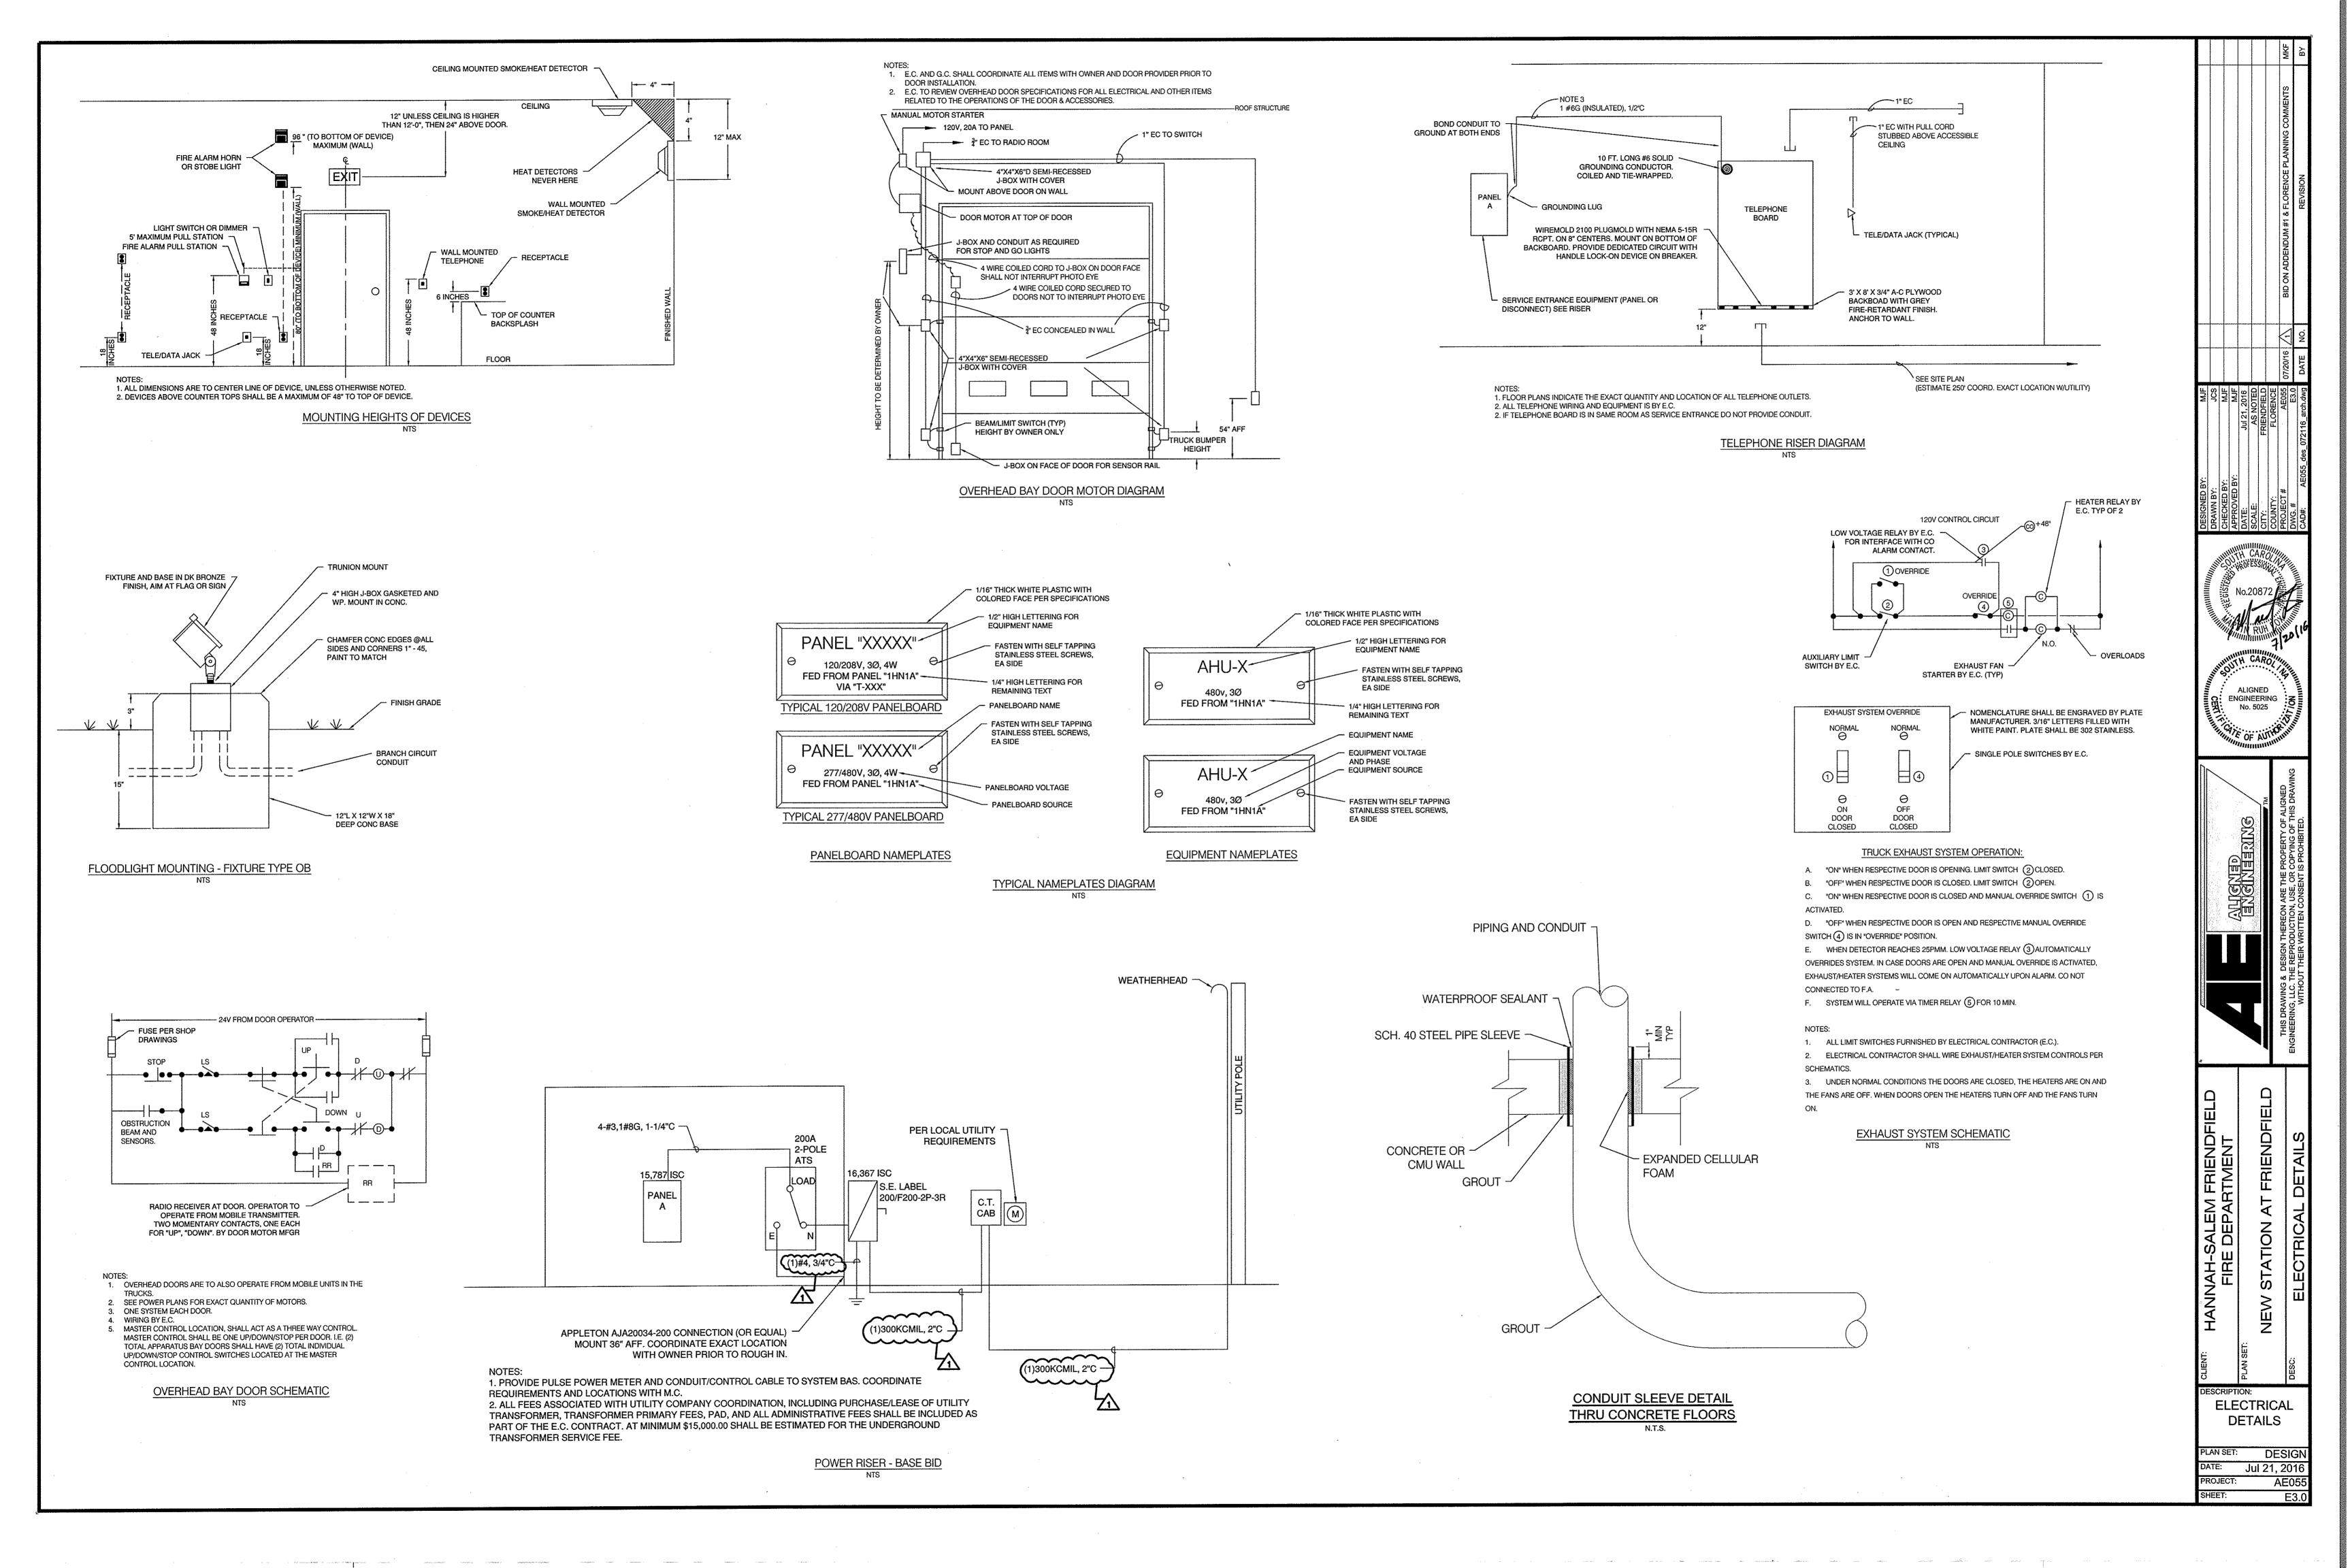

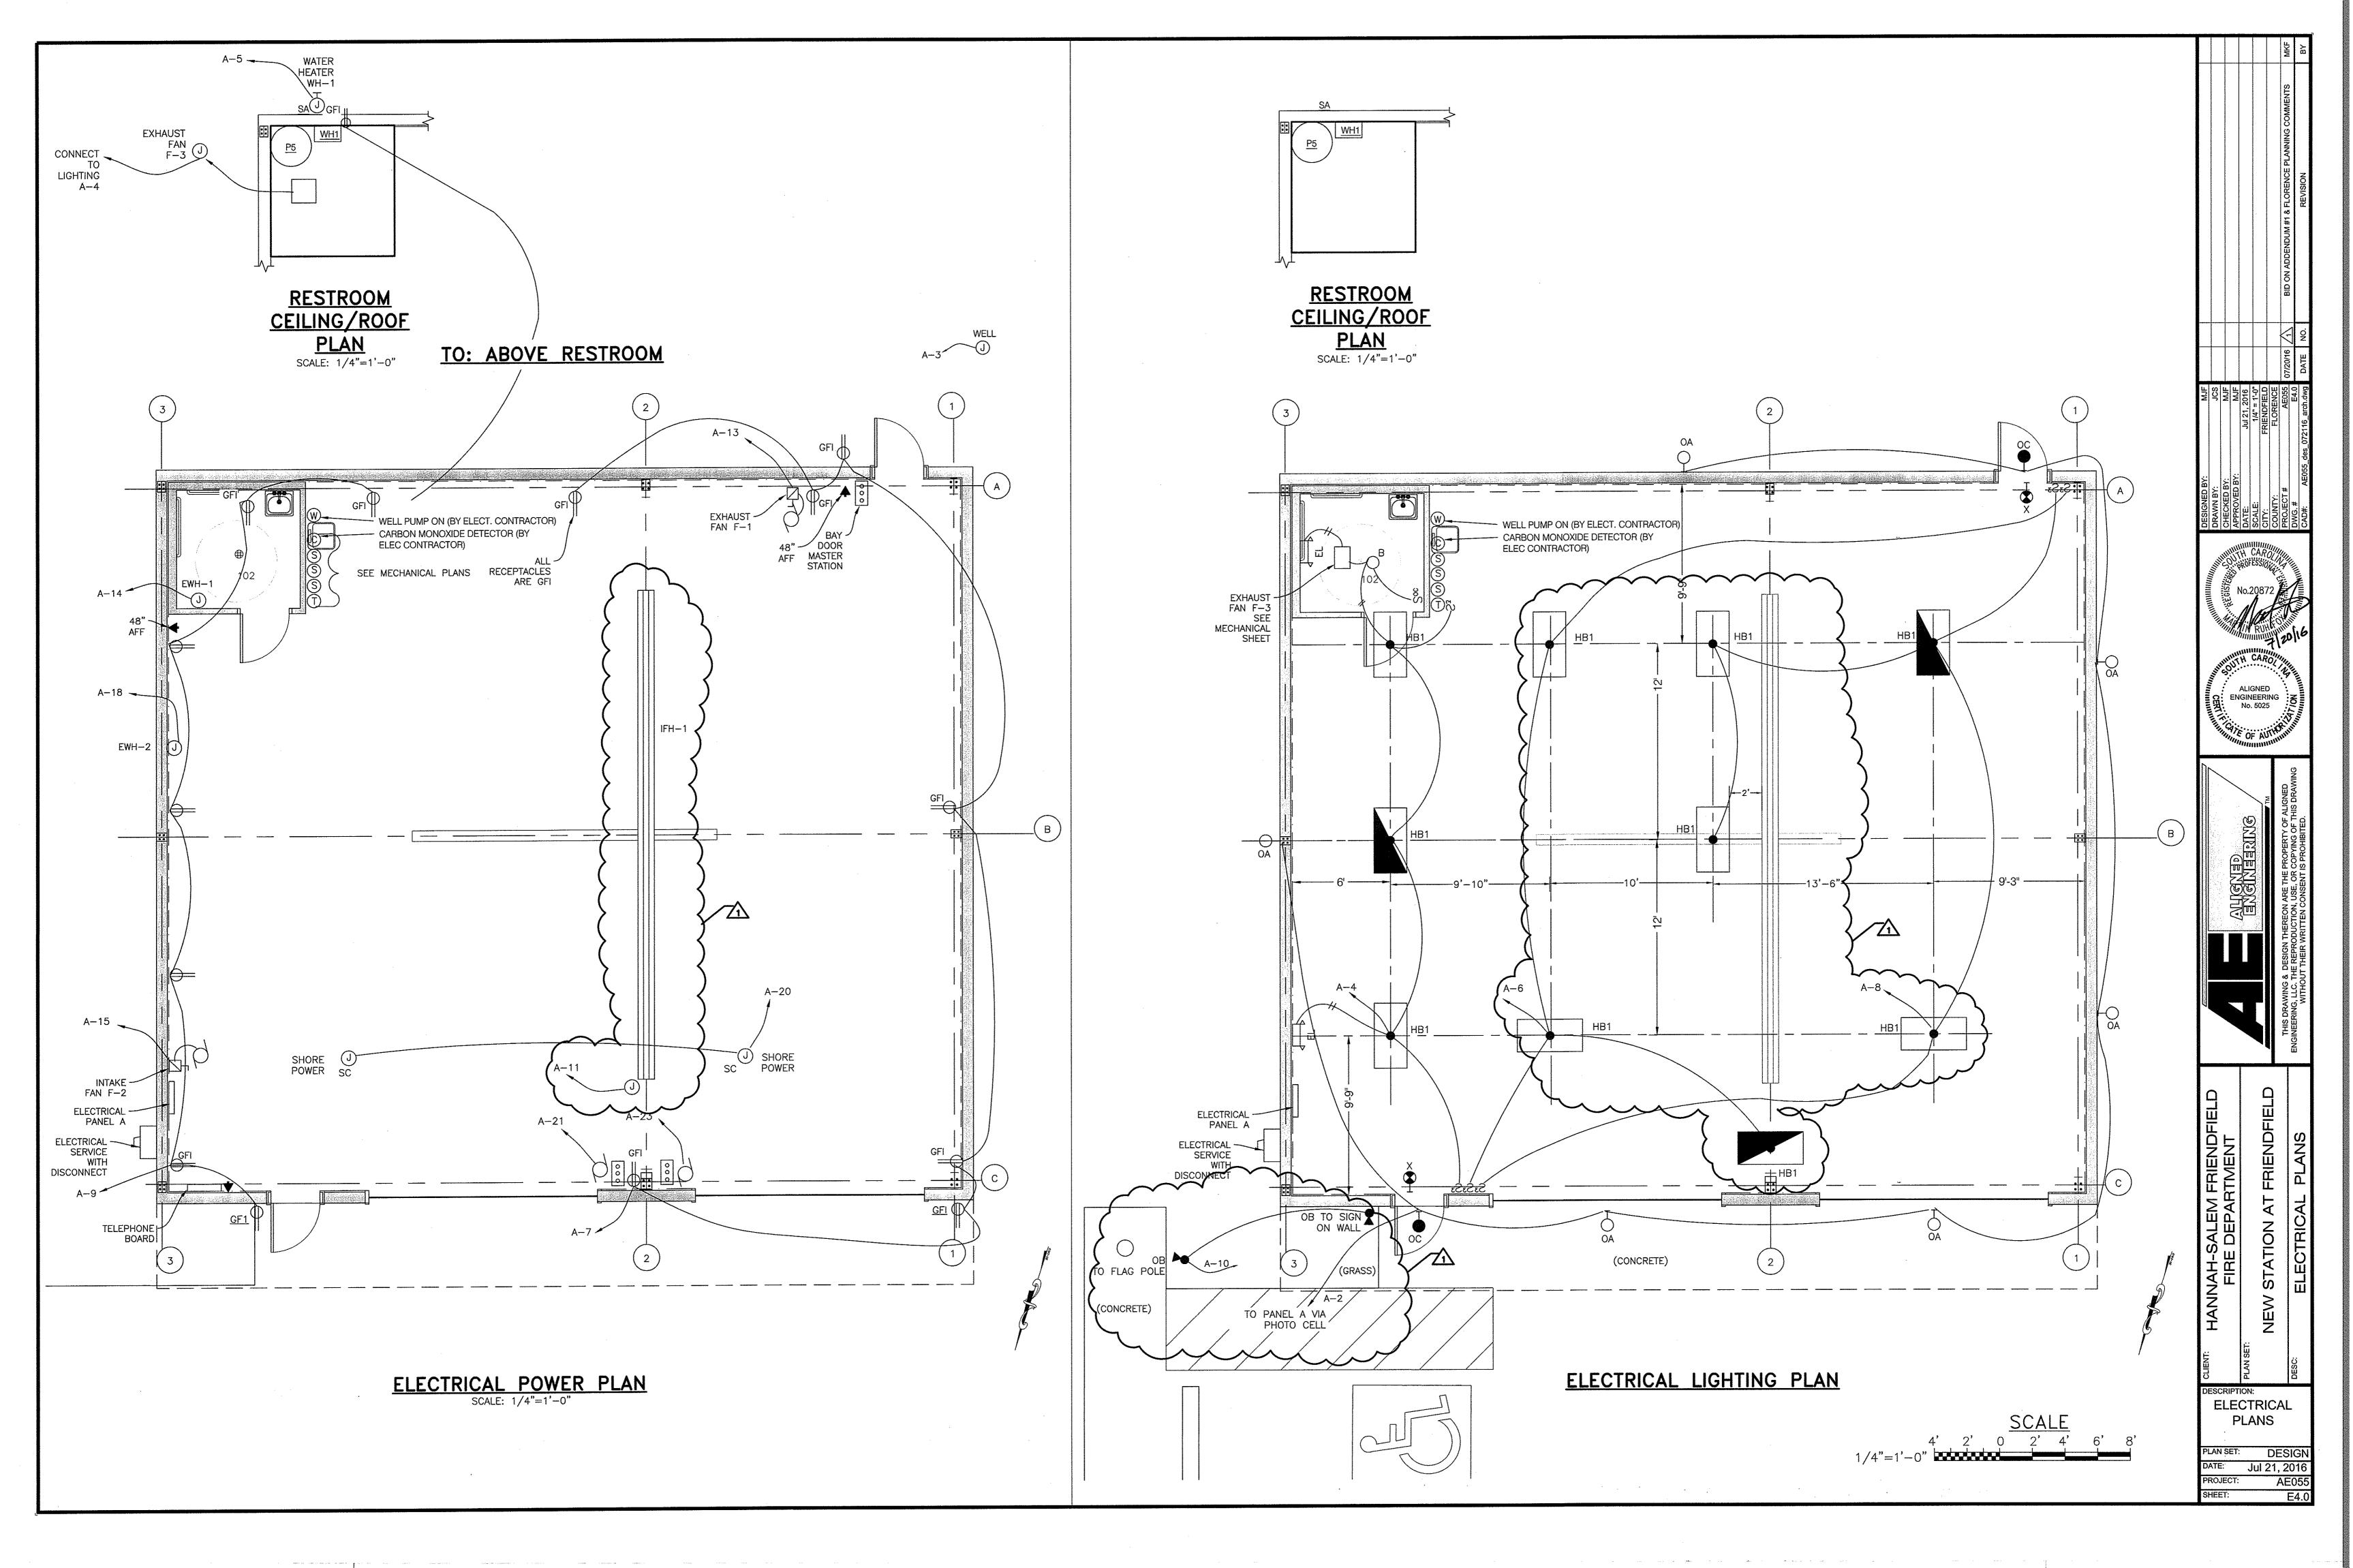

MECHANICAL (M) NOTES

GENERAL (MG) MG-1 DO NOT SCALE DRAWINGS. SEE ARCHITECTURAL DRAWINGS AND REFLECTED CEILING PLANS FOR EXACT LOCATION OF DOORS, WINDOWS, CEILING DIFFUSERS, ETC.

- MG-2 ALL COST ASSOCIATED WITH SUBSTITUTED EQUIPMENT TO COMPLY WITH BASIS OF DESIGN, INCLUDING PROVIDING MAINTENANCE ACCESS, CLEARANCE, PIPING, SHEET METAL, ELECTRICAL, REPLACEMENT OF OTHER SYSTEM COMPONENTS, BUILDING ALTERATIONS, ETC., SHALL BE INCLUDED IN THE ORIGINAL BASE BID. NO ADDITIONAL COST ASSOCIATED WITH SUBSTITUTED EQUIPMENT DURING CONSTRUCTION WILL BE ACCEPTED AND ALL COST WILL BE THE RESPONSIBILITY OF THE MECHANICAL CONTRACTOR, THIS INCLUDES ANY MODIFICATIONS TO ANY ASSOCIATED MECHANICAL, PLUMBING, OR ELECTRICAL SYSTEMS REQUIRED BY THIS SPECIFIC MANUFACTURER'S INSTALLATION INSTRUCTIONS.
- MG-3 UPON PROJECT COMPLETION, THE MECHANICAL CONTRACTOR IS RESPONSIBLE FOR PROVIDING THE OWNER INSTALLATION INFORMATION INCLUDING RECORD SUBMITTALS (WITH ANY SUBMITTAL REVIEW COMMENTS ADDRESSED) AND O&M MANUALS FOR EACH PIECE OF EQUIPMENT INCLUDING ALL SELECTED OPTIONS, THE NAME AND ADDRESS OF AT LEAST ONE SERVICE AGENCY, FULL CONTROL SYSTEM O&M AND CALIBRATION INFORMATION INCLUDING WIRING DIAGRAMS, SCHEMATICS, FULL SEQUENCE OF OPERATION, AND PROGRAMMED
- MG-4 PROVIDE A ONE YEAR WARRANTY FOR ALL WORK PERFORMED BEGINNING ON THE DAY THE SYSTEM IS COMPLETELY OPERATIONAL AND ACCEPTABLE BY THE OWNER.
- MG-5 THE MECHANICAL CONTRACTOR SHALL BE RESPONSIBLE FOR PROVIDING RESTRAINTS TO RESIST THE EARTHQUAKE EFFECTS ON THE MECHANICAL SYSTEMS. THE REQUIREMENTS FOR THOSE RESTRAINTS ARE FOUND IN THE LOCAL BUILDING CODE AND ASCE 7.
- 1 ALL DUCTWORK SHALL BE GALVANIZED SHEET METAL CONSTRUCTED IN ACCORDANCE WITH THE LATEST SMACNA STANDARDS, DUCT DIMENSIONS ON PLANS ARE FREE AREA SIZE.
- MD-2 ALL DUCTWORK SHALL BE SEALED PER THE REQUIREMENTS OF THE INTERNATIONAL MECHANICAL CODE. SEAL EXHAUST DUCTWORK FOR POSITIVE/NEGATIVE 2" PRESSURE CLASS, SMACNA SEAL CLASS A, SMACNA LEAKAGE CLASS 12.
- MD-3 ALL PIPING, DUCTS, VENTS, ETC., EXTENDING THROUGH WALLS AND ROOF SHALL BE FLASHED AND COUNTERFLASHED IN A WATERPROOF MANNER.
- MD-4 MECHANICAL; CONTRACTOR SHALL VERIFY LOCATION OF ROOF PENETRATIONS WITH ARCHITECT & OWNER PRIOR TO INSTALLATION.
- MD-5 MECHANICAL CONTRACTOR SHALL LOCATE EXHAUST FANS, OUTLETS, AND GAS FLUES A MINIMUM OF 15'-0" FROM ANY OUTSIDE AIR INTAKE.
- MD-6 ALL PIPING AND DUCTWORK LOCATIONS SHALL BE COORDINATED WITH THE WORK UNDER OTHER DIVISIONS OF THE SPECIFICATIONS, TO AVOID INTERFERENCE.
- EQUIPMENT (ME)
 ME-1 PROVIDE MANUFACTURER'S RECOMMENDED CLEARANCES AROUND ALL EQUIPMENT FOR MAINTENANCE AND FILTER REMOVAL.
- ME-2 ANY DEVICE REQUIRING A THERMOSTAT FOR CONTROL SHALL BE FURNISHED WITH A THERMOSTAT WHETHER INDICATED ON THE DRAWINGS OR NOT.
- ME-3 INSTALL THE TOP OF ALL THERMOSTATS, SENSORS, AND SWITCHES AT 4'-0" (MAXIMUM) ABOVE FINISH FLOOR, COORDINATE EXACT THERMOSTAT LOCATION WITH OWNER PRIOR TO
- ME-4 PROVIDE UNIONS, FLANGES OR COUPLINGS AT CONNECTION TO ALL VALVES AND EQUIPMENT. DO NOT USE DIRECT WELDED OR THREADED CONNECTIONS TO VALVES, EQUIPMENT, OR
- ME-5 PROVIDE NON-CONDUCTING DIELECTRIC UNIONS WHENEVER CONNECTING DISSIMILAR
- ME-6 EQUIPMENT OPERATED DURING CONSTRUCTION SHALL USE FILTERED MEDIA TO PREVENT CONSTRUCTION DEBRIS FROM ENTERING COILS, DUCTWORK SYSTEMS, AIR TERMINALS ETC. AT COMPLETION OF CONSTRUCTION, MECHANICAL CONTRACTOR SHALL CLEAN ALL SYSTEMS WITH ALL CONTROL DEVICES WIDE OPEN AND REMOVE ANY REMAINING DEBRIS PRIOR TO TEST AND BALANCING, MECHANICAL CONTRACTOR SHALL REPLACE ALL FILTRATION WITH NEW FILTERS AT COMPLETION OF CONSTRUCTION, ANY DUCTWORK, AIR TERMINALS, AND/OR OTHER EQUIPMENT UPSTREAM OF FILTRATION SHALL BE CLEANED THOROUGHLY OF CONSTRUCTION DEBRIS BEFORE HANDING OVER TO OWNER.

- NG-1 GAS PIPING AND FITTINGS ABOVE GRADE: SCH. 40 BLACK STEEL PIPING, TYPE S, SEAMLESS GRADE B (ASTM A 53) AND 150 PSI MALLEABLE BLACK IRON FITTINGS, GRADE 32510. (ASTM B 16.3) OR FORGED STEEL WELDING TYPE FITTINGS (ASTM A234), PROVIDE THREADED JOINTS FOR PIPE 2" AND SMALLER. PROVIDE WELDED JOINTS (ASME B31.9) FOR PIPE 2- ½" AND LARGER.
- NG-2 GAS PIPING AND FITTINGS OUTSIDE BELOW GRADE: SCH. 40 BLACK STEEL, TYPE S, SEAMLESS, GRADE B (ASTM A 53) AND FORGED STEEL WELDING TYPE FITTINGS (ASTM A234) WITH (AWWA C105) POLYETHYLENE JACKET OR DOUBLE LAYER, HALF LAPPED 10 MIL POLYETHYLENE TAPE. PROVIDE WELDED JOINTS (ASME B31.9) FOR ALL UNDERGROUND PIPE.
- NG-3 MINIMUM GAS PIPING SIZE SHALL BE 3/4".
- NG-4 PROVIDE UNIONS, FLANGES OR COUPLINGS AT CONNECTION TO ALL VALVES AND EQUIPMENT. DO NOT USE DIRECT WELDED OR THREADED CONNECTIONS TO VALVES, EQUIPMENT, OR
- NG-5 PROVIDE NON-CONDUCTING DIELECTRIC UNIONS WHENEVER CONNECTING DISSIMILAR
- NG-6 PAINT ALL GAS PIPING WITH 2 COATS OF YELLOW ENAMEL PAINT APPLIED WITH A BRUSH (2 MIL THICKNESS MINIMUM), STENCIL "GAS" ON PIPE AT 12'-0" CENTERS FOR ALL LOW PRESSURE PIPING (0.5 PSI). STENCIL "2-PSI GAS" ON PIPE AT 6'-0" CENTERS FOR 2 PSI GAS PIPING.
- NG-7 GAS PIPING SHALL BE INSTALLED TO THE REQUIREMENTS OF THE STATE BUILDING CODE AND NFPA STANDARD NO. 54. ALL PIPING TO BE SUPPORTED BY CLEVIS HANGERS WITH GALVANIZED ROD HANGERS IN THE PIPE RUN 12" OR LESS IN LENGTH FROM THE TOP OF THE PIPE TO THE SUPPORTING STRUCTURE PER THE STATE BUILDING CODE AND ASCE 7.
- NG-8 SPACE GAS PIPING HANGER RODS 7'-0" ON CENTER MAXIMUM AND SPACE TRANSVERSE BRACING 20'-0" ON CENTER MAXIMUM. TRANSVERSE BRACING FOR ONE SECTION MAY ACT AS LONGITUDINAL BRACING FOR THE PIPE SECTION CONNECTED TO IT IF THE BRACING IS INSTALLED WITHIN 24' OF THE ELBOW OR TEE. COORDINATE HANGER LOCATIONS WITH STRUCTURAL DRAWING DETAILS.
- NG-9 MECHANICAL CONTRACTOR SHALL LOCATE EXHAUST FANS, OUTLETS, AND GAS FLUES A MINIMUM OF 15'-0" FROM ANY OUTSIDE AIR INTAKE.
- NG-10GAS PIPING SHALL BE TESTED IN ACCORDANCE WITH THE PROCEDURES DESCRIBED IN NFPA NO 54. ANY OTHER TEST AS REQUIRED BY THE LOCAL GAS INSPECTION DEPARTMENT OR GAS COMPANY SHALL ALSO BE PERFORMED.
- NG-11PROVIDE A.G.A. CERTIFIED SHUT-OFF VALVES MINIMUM, 125 PSI, NON LUBRICATED PLUG TYPE WITH BRONZE BODY AND BRONZE PLUG, STRAINERS AND REGULATORS (AS RECOMMENDED BY THE EQUIPMENT MANUFACTURER) FOR ALL EQUIPMENT CONNECTED TO THE NATURAL GAS
- NG-12GAS PRESSURE REGULATORS SHALL COMPLY WITH ANSI Z21.80. REGULATORS SHALL BE CAST IRON OR DIE-CAST ALUMINUM CONSTRUCTION WITH INTERCHANGEABLE ZINC-PLATED STEEL SPRINGS, ZINC-PLATED STEEL DIAPHRAGM PLATE, NITRILE RUBBER SEAT DISC. INTERCHANGEABLE ALUMINUM ORIFICE, AND ULTRAVIOLET-STABILIZED MINERAL FILLED NYLON SEAL PLUG. REGULATOR SHALL BE SINGLE-PORT SELF-CONTAINED WITH ORIFICE NO LARGER THAN REQUIRED AT MAXIMUM PRESSURE INLET AND NO PRESSURE SENSING PIPING EXTERNAL TO THE REGULATOR. PRESSURE REGULATOR SHALL MAINTAIN DISCHARGE PRESSURE SETTING DOWNSTREAM AND NOT EXCEED 150 PERCENT OF DESIGN DISCHARGE PRESSURE AT SHUTOFF. OVERPRESSURE PROTECTION DEVICE SHALL BE FACTORY MOUNTED ON REGULATOR, WHEN USING VENTLESS REGULATORS, MOUNT REGULATOR IN A HORIZONTAL UPRIGHT POSITION. IF VENTED TYPE REGULATORS ARE USED, INSTALL VENT PIPING (FULL SIZE OPENING) FROM GAS PRESSURE REGULATORS TO OUTDOORS AND TERMINATE IN WEATHERPROOF HOOD.

MECHANICAL/ELECTRICAL COORDINATION (MEC) NOTES

- ELECTRICAL CONTRACTOR SHALL CONNECT AND/OR PROVIDE FINAL CONNECTIONS TO ALL PLUMBING AND MECHANICAL EQUIPMENT.
- ELECTRICAL CONTRACTOR SHALL COORDINATE ALL CONNECTIONS PRIOR TO ROUGH -
- IN USING APPROVED CATALOG SHEETS AND SHOP DRAWINGS. THE ELECTRICAL CONTRACTOR SHALL PROVIDE AND INSTALL ALL MANUAL STARTER SWITCHERS, DISCONNECT SWITCHES, RECEPTORS, ETC. TO MECHANICAL/PLUMBING

EQUIPMENT, ALL STARTERS (OTHER THAN MANUAL STARTER SWITCHES) SHALL BE

ALL DISCONNECT SWITCHES AND FUSE SIZES SHALL BE COORDINATED WITH SHOP DRAWINGS PRIOR TO INSTALLATION. ANY EQUIPMENT INSTALLED INCORRECTLY BECAUSE OF OR LACK OF COORDINATION WILL BE REMOVED AND INSTALLED CORRECTLY AT THE ELECTRICAL CONTRACTOR'S EXPENSE.

PROVIDED BY OTHERS, BUT INSTALLED BY ELECTRICAL CONTRACTOR.

MEC-05 ELECTRICAL CONTRACTOR SHALL INSTALL ALL STARTERS PROVIDED BY OTHER TRADES.

EQUIVALENT MANUFACTURERS LISTING

LISTING OF MANUFACTURER'S NAME DOES NOT GUARANTEE APPROVAL. ALL EQUIPMENT MUST MEET OR EXCEED QUALITY AND CAPACITIES OF SPECIFIED EQUIPMENT. FINAL APPROVAL WILL BBE BASED ON EQUIPMENT SUBMITTALS. ANY MANUFACTURER NOT LISTED BUT WISHING TO BID THIS PROJECT SHALL SUBMIT A WRITTEN REQUEST A MINIMUM OF 7 DAYS PRIOR TO BID DATE OR AS INDICATED IN THE SPECIFICATIONS, PRIOR APPROVAL IS REQUIRED FOR ALL MANUFACTURERS NOT LISTED.

(ALPHABETICAL ORDER)

FANS: COOK, GREENHECK, PENN LOUVER: AIR BALANCE INC., GREEN HECK, RUSKIN, SAFE-AIR FLECTRIC UNIT HEATERS: REZNOR, MARKEL, MODINE RADIANT HEATERS: SPACE RAY, RE-VERBBER-RAY, ROBERTS GORDON

ALL COST ASSOCIATED WITH SUBSTITUTED EQUIPMENT TO COMPLY WITH BASIS OF DESIGN, INCLUDING PROVIDING MAINTENANCE ACCESS, CLEARANCE, PIPING, SHEET METAL, ELECTRICAL, REPLACEMENT OF OTHER SYSTEM COMPONENTS, BUILDING ALTERATIONS, ETC., SHALL BE INCLUDED IN THE ORIGINAL NO ADDITIONAL COST ASSOCIATED WITH SUBSTITUTED EQUIPMENT WILL BE APPROVED DURING CONSTRUCTION AND ALL COST WILL BE THE RESPONSIBILITY OF THE MECHANICAL CONTRACTOR.

FAN SCHEDULE

- 1	ł.										
								ELEC	TRICA	AL DATA	MANUFACTURE
	SYMBOL	LOCATION	TYPE	<u>CFM</u>	APPROX. S.P.	DRIVE	FAN RPM	WATTS	<u>H.P.</u>	VOLTAGE	<u>GREENHECK</u>
	<u>F-1</u>	APP. BAY	SUPPLY	4,000	0.25"	BELT	983	-	1/3	120V-1Ø	SBS-1H24
	<u>F-2</u>	APP. BAY	EXHAUST	4,000	0.25"	BELT	983	-	1/3	120V-1Ø	SBE-1H24
	<u>F-3</u>	RESTROOM	EXHAUST	250	0.25"	DIRECT	1000	83	-	120V-1Ø	SP-A150

ACCESSORIES

- A. DISCONNECT SWITCH B. GRAVITY BACKDRAFT DAMPER

E. WL, WALL LOUVER DISCHARGE

F. WALL MOUNTING COLLAR

- C. BIRDSCREEN
- D. HANGING BRACKETS WITH VIBRATION ISOLATION
- G. SIDEWALL PROPELLER FANS SHALL HAVE MOTOR FACTORY MOUNTED & ACCESSIBLE BETWEEN OCCUPIED SPACE AND FAN BLADES FOR BOTH SUPPLY AND EXHAUST ARRANGEMENTS.
- H. MOTORSIDE FAN GUARD I. EXHAUST GRILLE

- 1. ALL FANS SHALL BE U.L. LISTED AND LABELED AND SHALL BE AMAC CERTIFIED FOR SOUND AND AIR FLOW. ALL FANS INSTALLED INSIDE, ABOVE, OR ADJACENT TO OCCUPIED SPACES SHALL HAVE A MAXIMUM 9.0 INLET SONE LEVEL
- 2. ALL FANS SHALL BE SUPPLIED BY ONE MANUFACTURER UNLESS NOTED OTHERWISE.
- MECHANICAL CONTRACTOR SHALL PROVIDE MAGNETIC STARTER WITH AUXILLARY CONTACTS AS REQUIRED.
 PROVIDE ALL DIRECT DRIVE FANS WITH CONSTAND SPEED CONTROLLERS.
 FANS F-3 SHALL HAVE INTERLOCK WITH ROOM LIGHT SWITCH (FAN SHALL OPERATE WHEN LIGHT IS ON IN ANY ROOM
- SERVED BY FAN), AND WALL MOUNTED MUSHROOM PUSH BUTTON SWITCH/STARTER WITH IDENTIFICATION LABEL (VERIFY STARTER REQUIREMENTS WITH E.C.) INTERLOCK ASSOCIATED SUPPLY AND EXHAUST FANS; OVERRIDDEN BY CO SENSOR HIGH READING.
- 6. FANS_F-1 AND F-2 ACCESSORIES: A, B, C, D, F, G, H. FAN(F-3)SHALL INTERLOCK WITH ROOM LIGHT SWITCH (FAN SHALL OPERATE WHEN LIGHT IS ON IN ANY ROOM SERVED BY FAN)
- 8. FAN F-3 ACCESSORIES: A, B, D, E, I.

INFRARED RADIANT HEATER SCHEDULE

SYMBOL	GAS INPUT	MOUNTING	TUBE	FLUE	ELEC	TRICAL DATA	MANUFACTURER
	(MBH)	ANGLE	LENGTH	SIZE	FLA.	VOLTAGE	SPACE RAY MODEL
<u>IFH-1</u>	60,000	<u>0°</u>	<u>30'</u>	<u>4"Ø</u>	2.6	120V-1Ø	LTS60-30

NOTES:

1. INFRARED HEATERS SHALL BE AGA CERTIFIED. 2. UNITS SHALL BE SUPPLIED WITH: GLO-BAR OR OTHER NON-PILOT IGNITION, 24V THERMOSTAT

RELAY KIT, 24V THERMOSTAT, PROPANE CONVERSION KIT.

PROVIDE THERMOSTAT AS INDICATED ON PLANS.

PROVIDE 2 PSI - 0.5 PSI REGULATOR FOR THE HEATER. COORDINATE EXACT MOUNTING HEIGHT WITH GC & OWNER PRIOR TO INSTALLATION.

EQUIPMENT SHALL BE SUPPORTED PER MANUFACTURER'S INSTALLATION INSTRUCTIONS.

INTERNATIONAL ENERGY CONSERVATION CODE

IECC 2006 SECTION 501.1 COMPLIANCE WITH ASHRAE 90.1

MECHANICAL SUMMARY

MECHANICAL SYSTEMS, SERVICE SYSTEMS AND

EQUIPMENT METHOD OF COMPLIANCE:

PERFORMANCE PRESCRIPTIVE X ENERY COST BUDGET

CLIMATE ZONE: 3A- FLORENCE COUNTY, SC

EXTERIOR DESIGN CONDITIONS

WINTER DRY BULB

SUMMER DRY BULB

96° F. INTERIOR DESIGN CONDITIONS

WINTER DRY BULB SUMMER DRY BULB N/A - NO COOLING

RELATIVE HUMIDITY BUILDING HEATING LOAD

85,380 BTUH

27° F.

BUILDING COOLING LOAD

MECHANICAL SPACING CONDITIONING SYSTEM UNITARY

DESCRIPTION OF UNIT HEATING EFFICIENCY

INFRARED AND ELECTRIC HEATERS SEE EQUIPMENT SCHEDULE

N/A - NO HUMIDITY CONTROL

COOLING EFFICIENCY HEAT OUTPUT OF UNIT COOLING OUTPUT OF UNIT

SEE EQUIPMENT SCHEDULE

TOTAL BOILER OUTPUT OF UNIT

TOTAL CHILLER CAPACITY

LIST EQUIPMENT EFFICIENCIES

EQUIPMENT SCHEDULES WITH MOTORS (MECHANICAL SYSTEMS) MOTOR HORSEPOWER NUMBER OF PHASES MINIMUM EFFICIENCY N/A MOTOR TYPE


SIGNED: NAME: MARTIN FOX, P.E.


TITLE: MECHANICAL ENGINEER

OF POLES

VENTILATION CALCU	LATIONS (I	MC 2012,	SECT 403):						
OCCUPANCY CLASSIFICATION	PEOPLE O/A RATE IN BREATHING ZONE (CFM/PERSON)	AREA O/A RATE IN BREATHING ZONE (CFM/SQ. FT.)	DEFAULT OCCUPANCY DENSITY (PEOPLE/1000 SQ. FT.)	EXHAUST AIRFLOW RATE (CFM/SQ. FT.)	AREA (SQ. FT.)	CALCULATED OCCUPANCY (PEOPLE)	CALCULATED PEOPLE O/A (CFM)	CALCULATED AREA O/A (CFM)	CALCULATED AREA E/A (CFM)
REPAIR GARAGES, ENCLOSED, PARKING GARAGES	0	0.000000	0	0.750000	2,250	0	0	0	1,688
			<u> </u>			BUILDING TOTAL			1,688 4,000

	MECHANICAL	LEGEND
SYMBOL	•	DESCRIPTION
1		THERMOSTAT/TEMP SENSOR (4'-0" AFF TO TOP)
S		SWITCH (4'-0" AFF TO TOP)
©		CARBON MONOXIDE SENSOR (4'-0" AFF TO TOP) (SENSOR BY EC)
		EXHAUST AIR GRILLE
		DOUBLE LINE DUCTWORK
8" (ð	8" DIAMETER ROUND DUCT

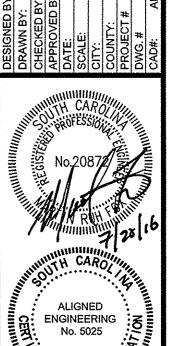


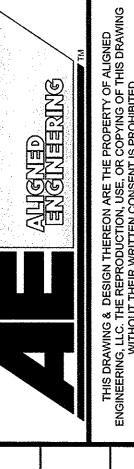


STATION

MECHANICAL NOTES

DESIG Jul 21, 201 AE05

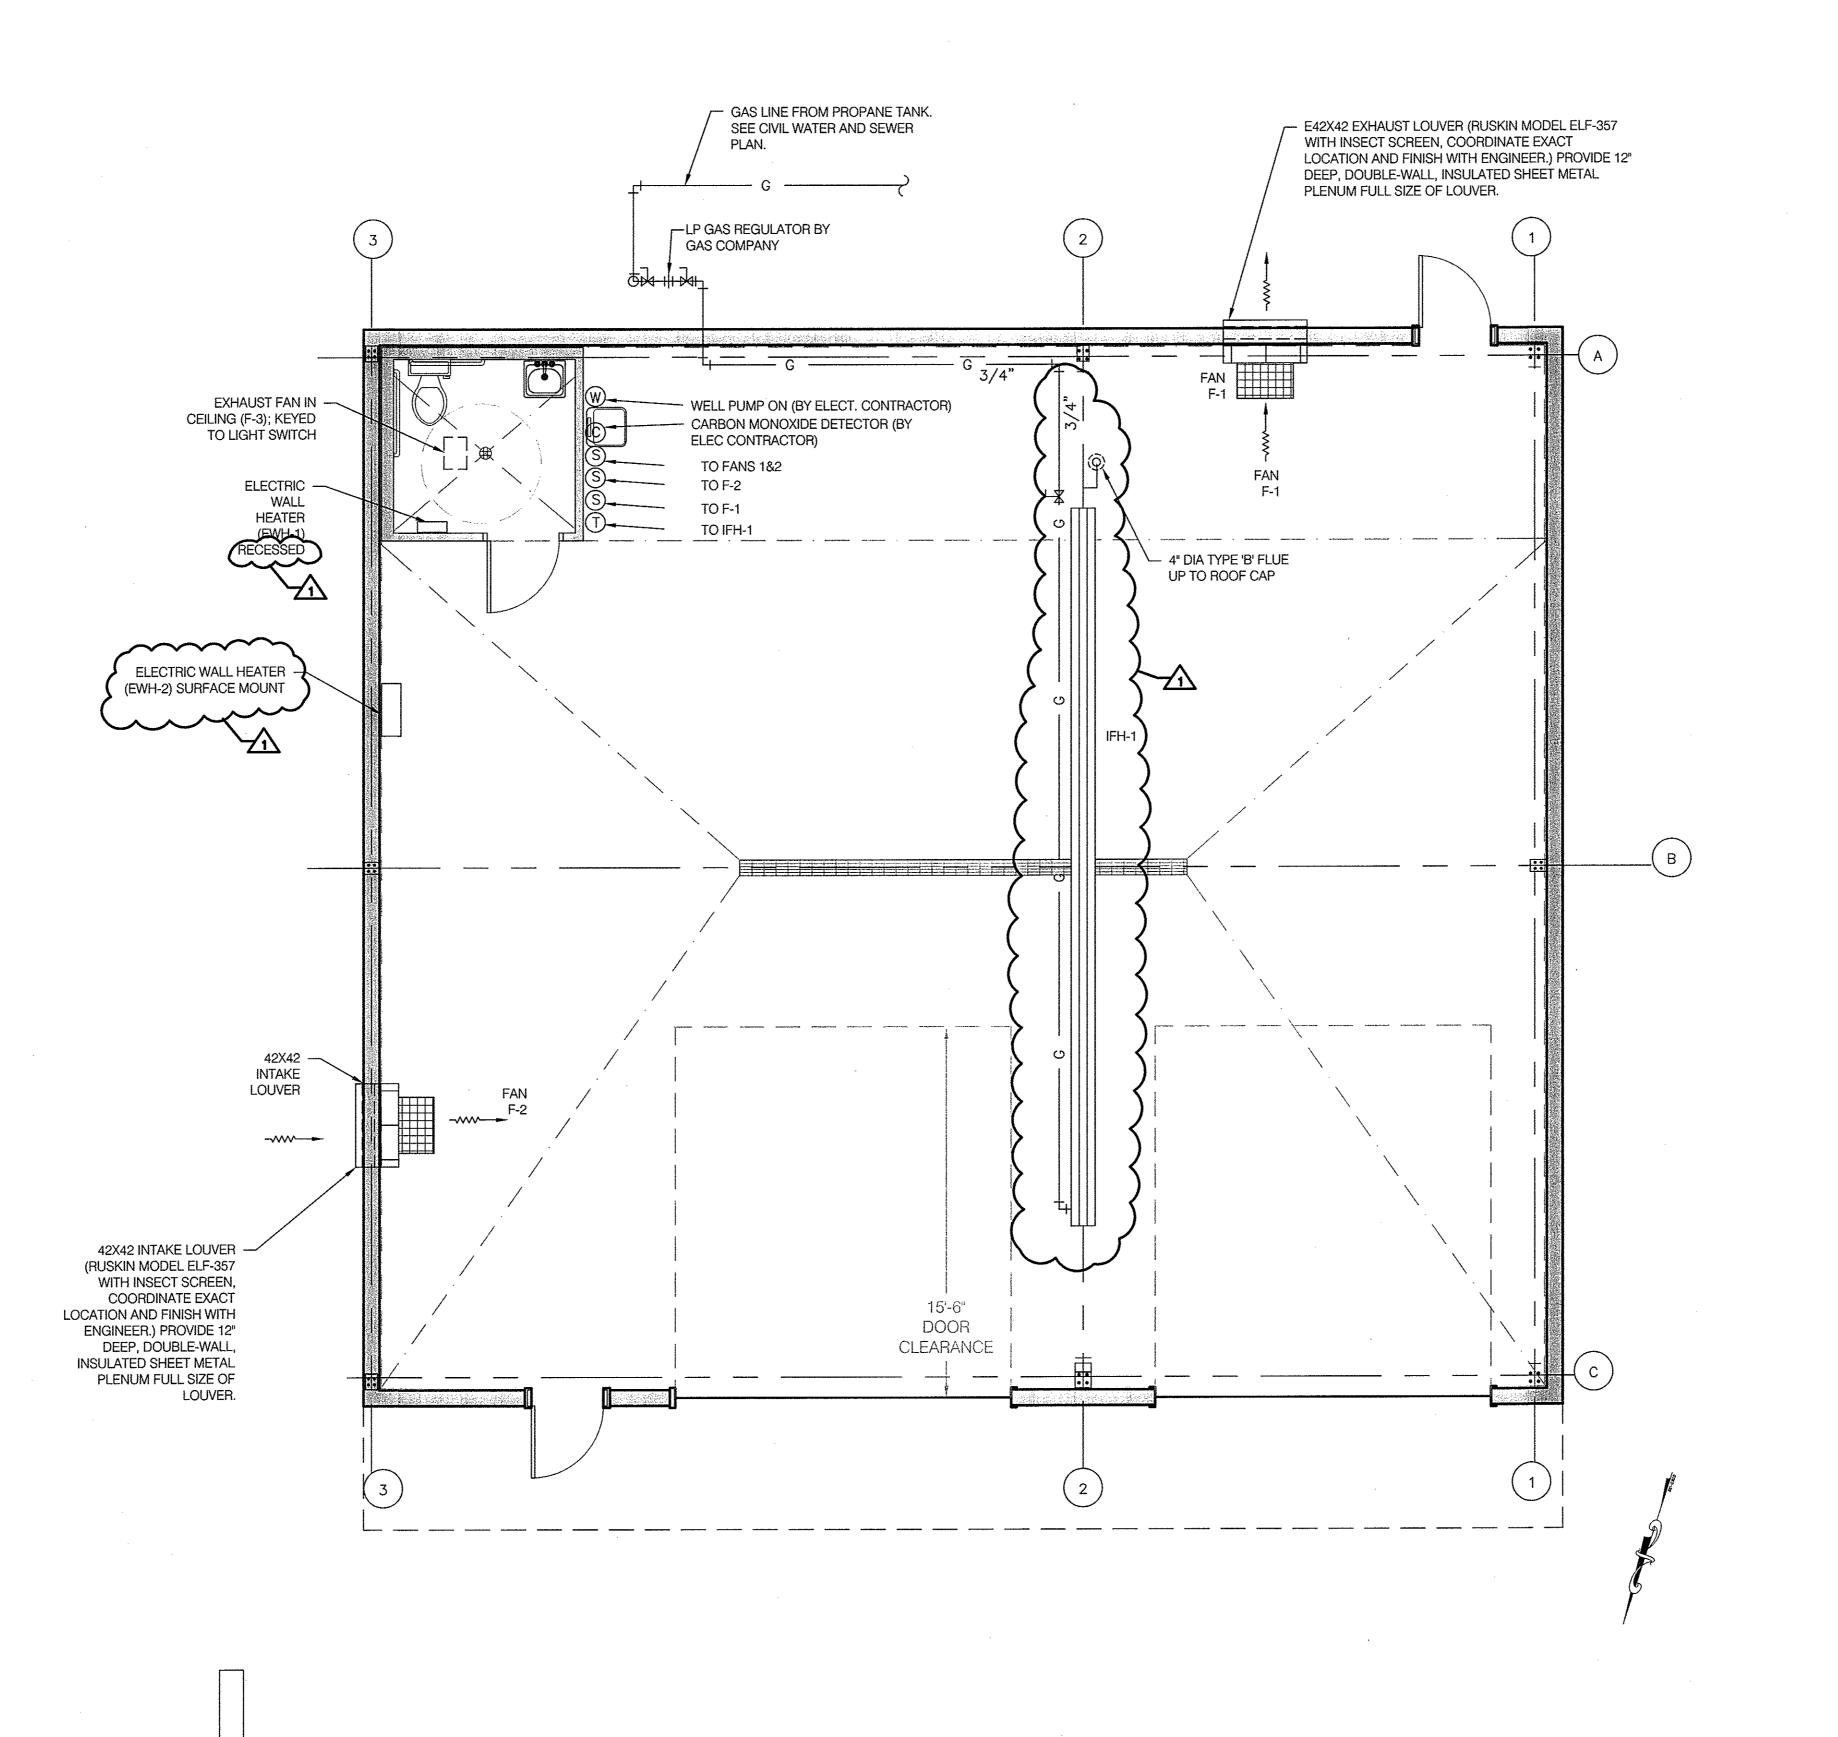

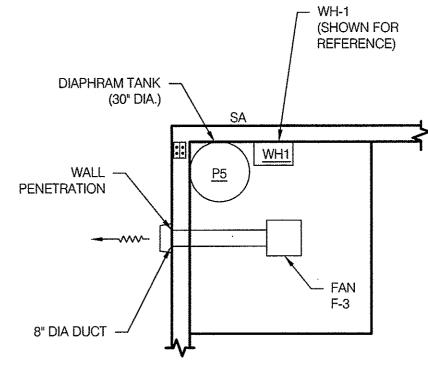

RESTROOM CEILING/ROOF **PLAN**

SCALE: 1/4"=1'-0"


MECHANICAL LEGEND SYMBOL DESCRIPTION THERMOSTAT/TEMP SENSOR (4'-0" AFF TO TOP) SWITCH (4'-0" AFF TO TOP) CARBON MONOXIDE SENSOR (4'-0" AFF TO TOP) (SENSOR BY EC) EXHAUST AIR GRILLE DOUBLE LINE DUCTWORK 8" DIAMETER ROUND DUCT

SCALE 4' 2' 0 2' 4' 6' 8'	<u> </u>	 				
		<u>S</u>	CA	<u>LE</u>		
1/4"=1'-0"	1/4"=1'-0"	0	2'	4'	6'	8'

AUGNED ENGINEERING


MECHANICAL FLOOR PLANS

PLAN SET: DESIGN Jul 21, 2016 AE055

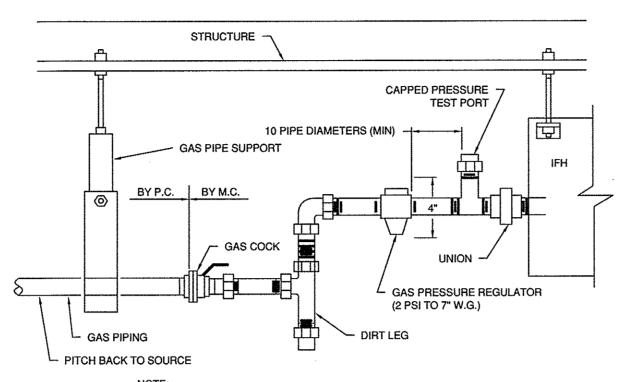

NOTE:
1. PROVIDE DIELECTRIC UNIONS WHERE DISSIMILAR METALS ARE JOINED. 2. GAS PIPING AND SHUT-OFF VALVE SHALL BE BY PLBG. CONTR., DIRT LEG, REGULATOR AND FINAL CONNECTION TO UNIT SHALL BE BY MECH. CONTR.


IFH GAS CONNECTION DETAIL
NTS

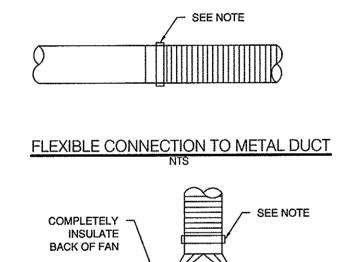


FLEXIBLE CONNECTION TO EXHAUST FAN

EXHAUST FAN

NOTE: ALL FLEXIBLE DUCT CONNECTIONS TO SHEET METAL SHALL BE SECURED WITH APPROVED STRAP AND SEALANT.

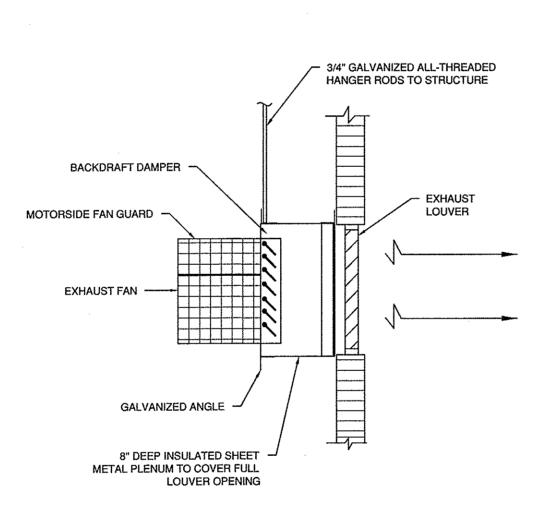

EXHAUST FAN DETAIL NTS

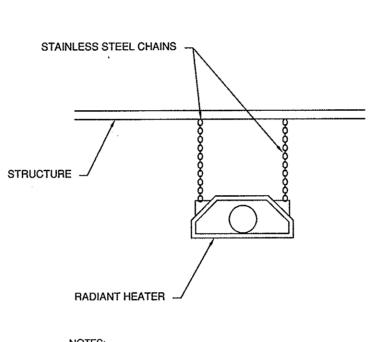

NOTES:

1. MOUNT HEATER FROM EXPOSED STRUCTURE WITH A 24" MINIMUM SIDE CLEARANCE AND 12" MINIMUM TOP CLEARANCE TO COMBUSTIBLES.

2. THE BOTTOM OF THE HEATER MUST BE A MINIMUM OF 60" ABOVE COMBUSTIBLES.


3. INFRARED HEATERS SHALL BE AGA CERTIFIED.


4. VERIFY EXACT MOUNTING HEIGHT AND LOCATION WITH G.C. & OWNER PRIOR TO INSTALLATION.

5. BOUTEA" OF TYPE "B" VENT LIP TO BOOK CAP (MIN. 36" ABOVE BOOK)

ROUTE4"Ø TYPE "B" VENT UP TO ROOF CAP (MIN. 36" ABOVE ROOF). REFER TO SHEET M1.1 FOR VENT ROUTING.

INFRARED RADIANT HEATER (IFH) DETAIL

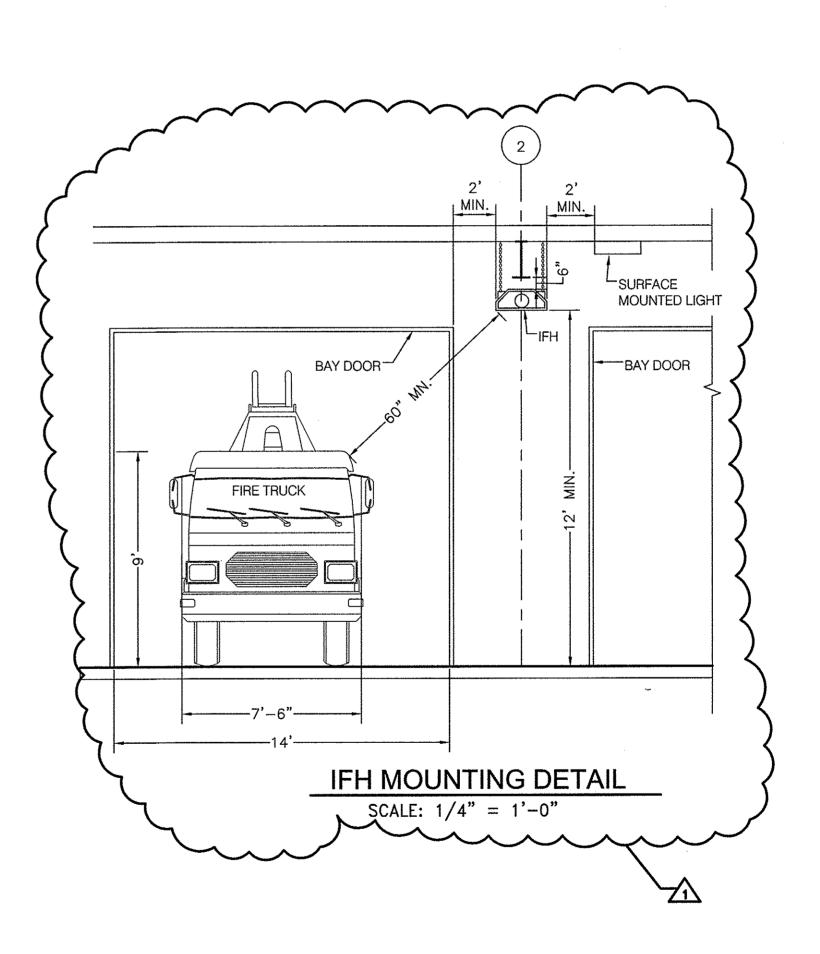

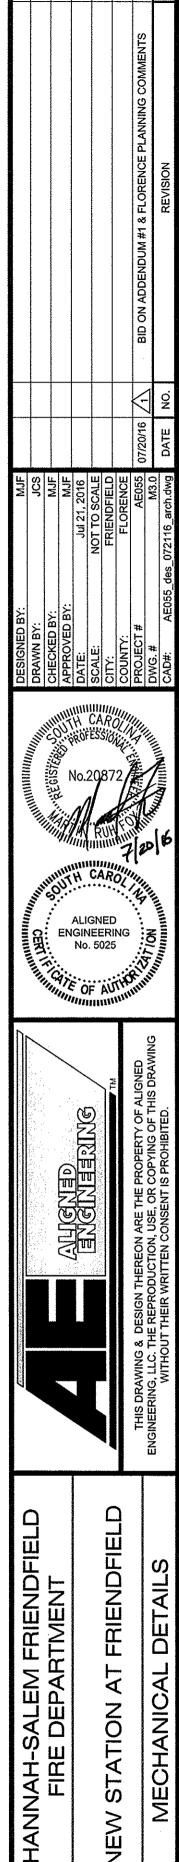

MECHANICAL **DETAILS**

PLAN SET: DESIGN Jul 21, 2016 AE055 M3.0

PLUMBING (P) NOTES

- SCOPE: PROVIDE ALL LABOR, MATERIAL AND EQUIPMENT REQUIRED FOR THE COMPLETION AND OPERATION OF ALL PLUMBING SYSTEMS IN ACCORDANCE WITH ALL APPLICABLE CODES.
- PG-2 PERMITS: APPLY AND PAY FOR ALL NECESSARY PERMITS, FEES AND INSPECTIONS REQUIRED BY ANY PUBLIC AUTHORITY HAVING JURISDICTION. ACREAGE CHARGES, FACILITIES CHARGES AND BOND PROPERTY ASSESSMENTS ARE
- PG-3 WARRANTY: PROVIDE A ONE YEAR WARRANTY, FROM THE DATE OF ACCEPTANCE OF WORK BY THE OWNER, FOR
- PG-4 SUBSTITUTIONS: THE PLUMBING CONTRACTOR IS RESPONSIBLE FOR ALL COSTS ASSOCIATED WITH SUBSTITUTIONS TO SPECIFIED PLUMBING FIXTURES AND EQUIPMENT INCLUDING BUT NOT LIMITED TO; PROVIDING MAINTENANCE ACCESS CLEARANCE, PIPING, ELECTRICAL, REPLACEMENT OF OTHER SYSTEM COMPONENTS, BUILDING ALTERATIONS, ETC. AND ANY MODIFICATIONS TO ASSOCIATED MECHANICAL, ELECTRICAL OR PLUMBING SYSTEMS REQUIRED BY THE EQUIPMENTS INSTALLATION INSTRUCTIONS. ALL COSTS ASSOCIATED WITH SUBSTITUTIONS SHALL BE INCLUDED IN THE ORIGINAL BASE BID.
- PG-5 COORDINATE ALL PLUMBING PIPING LOCATIONS, ROUGH-IN LOCATIONS AND EQUIPMENT LOCATIONS SHALL BE A CODE COMPLAINT INSTALLATION FOR ALL TRADES.
- PG-6 PLUMBING PLANS SHALL NOT BE SCALED. REFERENCE THE ARCHITECTURAL PLANS FOR ALL LOCATIONS OF PLUMBING FIXTURES, WALLS, DOORS, WINDOWS, ETC.
- PG-7 PLUMBING SYSTEMS INCLUDE, BUT ARE NOT LIMITED TO: PLUMBING FIXTURES AND EQUIPMENT, FIRE STOPPING, SEISMIC BRACING, PIPE IDENTIFICATION, DOMESTIC WATER SYSTEM, SANITARY WASTE AND VENT SYSTEM, LP GAS
- PG-8 PROVIDE COMPLETE PLUMING FIXTURES AND EQUIPMENT. INCLUDE SUPPLIES, STOPS, VALVES, FAUCETS, DRAINS, TRAPS, TAIL PIECES, ETC
- PG-9 VERIFY PROPER OPERATION OF EXISTING SYSTEMS BEFORE STARTING CONSTRUCTION. NOTIFY THE ARCHITECT/ENGINEER OF RECORD OF ANY PROBLEMS OR DISCREPANCIES BETWEEN THE OBSERVED SYSTEM BEFORE
- PG-10 WHERE DISCREPANCIES ARE FOUND IN THE DRAWINGS AND SPECIFICATIONS THE MORE STRINGENT SHALL APPLY. CONTACT ENGINEER FOR CLARIFICATION.
- PG-11 ALL PIPING SHALL BE MANUFACTURED IN THE UNITED STATES OF AMERICA.

NOT TO BE CONSTRUED TO BE A PART OF THIS CONTRACT.

ALL PLUMBING MATERIALS AND EQUIPMENT.

CONTINUING WORK IN THE EFFECTED AREAS.

- PG-12 ALL VALVES, BACKFLOW PREVENTERS, BOOSTER PUMPS, ETC. SERVING THE DOMESTIC WATER SYSTEM SHALL MEET LEAD FREE STANDARDS PER ANSI/NSF 372 AND NSF 61, ANNEX G.
- PI-1 PLUMBING WORK SHALL BE INSTALLED IN ACCORDANCE WITH THE SOUTH CAROLINA STATE PLUMBING CODE AND WITH THE REQUIREMENTS OF THE LOCAL AUTHORITY HAVING JURISDICTION.
- PI-2 PLUMBING FIXTURES AND EQUIPMENT SHALL BE INSTALLED PER THE MANUFACTURER'S RECOMMENDATIONS AND INSTALLATION INSTRUCTIONS.
- PI-3 CUT WALLS. FLOORS AND CEILINGS AS REQUIRED FOR INSTALLATION OF PLUMBING WORK. ALL CUTTING SHALL BE
- HELD TO A MINIMUM. PATCH AND FINISH SURFACES TO MATCH ADJOINING SURFACES. PI-4 PLUMBING PIPING AND SPECIALTIES SHALL BE LOCATED CONCEALED IN WALLS, PARTITIONS OR ABOVE CEILINGS UNLESS NOTED OTHERWISE. PLUMBING PIPING IN EXPOSED AREAS SHALL BE RUN TIGHT TO UNDERSIDE OF STRUCTURE. PROVIDE ACCESS DOORS FOR CONCEALED SPECIALITIES.
- PI-5 PROVIDE ACCESS DOORS FOR VALVES, WATER HAMMER ARRESTORS, TRAP PRIMERS, ETC. CONCEALED IN MASONRY WALLS, GYPBOARD WALLS AND/OR CEILINGS THAT WILL REQUIRE MAINTENANCE ACCESS.
- PI-6 PROVIDE NON-CONDUCTING DIELECTRIC UNIONS WHENEVER CONNECTING DISSIMILAR METALS.
- 1. PIPE IDENTIFICATION SHALL MATCH THE FACILITY'S EXISTING STANDARD. IF NO STANDARD EXISTS, THEN THE PIPE IDENTIFICATION SHALL BE IN ACCORDANCE WITH ANSI A13.1.
- 2. PROVIDE PIPING LABELS FOR ALL PLUMBING PIPING. PIPING LABELS SHALL BE ACRYLIC FACED, WRAP-AROUND TYPE. EACH LABEL SHALL INDICATE THE PIPING CONTENTS, DIRECTION OF FLOW AND SHALL BEAR THE MANUFACTURER'S STANDARD COLOR FOR THE SERVICE INDICATED.
- PP-1 FIRE STOP ALL PENETRATIONS, BY PIPING OR CONDUITS, OF FIRE RATED WALLS, FLOORS, AND PARTITIONS. PROVIDE A DEVICE(S) OR SYSTEM(S) WHICH HAS BEEN TESTED AND LISTENED AS COMPLYING WITH ASTM E-814 AND INSTALL IN ACCORDANCE WITH THE CONDITIONS OF THEIR LISTING. PROVIDE A DEVICE9S) OR SYSTEM(S) WITH AN 'f' RATING EQUAL TO THE RATING OF THE ASSEMBLY BEING PENETRATED. REFER TO ARCHITECTURAL PLANS FOR WALL AND FLOOR TYPES
- PP-2 PLUMBING PIPING, VENTS, ETC. EXTENDING THROUGH EXTERIOR WALLS AND/OR THE ROOF SHALL BE FLASHED AND COUNTER FLASHED IN A WATERPROOF MANNER. COORDINATE FLASHING WITH THE GENERAL CONTRACTOR.
- PP-3 DO NOT INSTALL PLUMBING PIPING IN AREAS SUBJECT TO FREEZING TEMPERATURES. INSTALL PLUMBING PIPING SHOWN IN EXTERIOR WALLS ON THE CONDITIONED SIDE OF THE WALL INSULATION.
- SEISMIC BRACING (PB)
- PROPERLY SUPPORT AND BRACE VERTICALLY AND HORIZONTALLY ALL PIPING, APPARATUS, EQUIPMENTS, ETC. IN ACCORDANCE WITH APPLICABLE CODES TO PREVENT EXCESSIVE MOVEMENT DURING SEISMIC CONDITIONS.
- PB-2 ATTACH HANGERS TO STRUCTURE, HANGERS SHALL NOT ATTACH TO THE DECK.
- DOMESTIC WATER PIPING (DW)
- DW-1 DOMESTIC WATER PIPING AND JOINTS BELOW GRADE: PROVIDE PEX PIPING AND JOINTS.
- DW-2 DOMESTIC WATER PIPING AND JOINTS ABOVE GRADE; PROVIDE PEX PIPE AND JOINTS.
- STERILIZE THE DOMESTIC WATER SYSTEM IN ACCORDANCE WITH THE AMERICAN WATER WORKS ASSOCIATION'S SPECIFICATIONS AND LOCAL HEALTH DEPARTMENT REGULATIONS.
- DW-4 INSULATE DOMESTIC WATER PIPING ABOVE GRADE (EXCEPT EXPOSED CONNECTIONS TO PLUMBING FIXTURES) WITH GLASS FIBER INSULATION HAVING A VAPOR BARRIER AND JACKET. PIPE INSULATION SHALL HAVE A. CONDUCTIVITY NOT EXCEEDING 0.27 BTUH X SQ. FT. FOLLOW SCHEDULE BELOW:
 - SERVICE TYPE PIPE SIZES INSULATION THICKNESS

 DOMESTIC HOT WATER 1/2"-1 1/4" 1"

 DOMESTIC COLD WATER 1/2' 1 1/4" 1/2"
- DOMESTIC COLD WATER 1 1/2" - 4"
- DW-5 DOMESTIC WATER PIPING INSULATION, JACKETS, COVERINGS, SEALERS, MASTICS, AND ADHESIVES ARE REQUIRED TO MEET A FLAME-SPREAD RATING OF 25 OR LESS AND A SMOKE-DEVELOPED RATING OF 50 OR LESS. AS TESTED BY ASTM E84 (NFPA 255) METHOD AND SHALL BE PLENUM RATED. PROVIDE PVC JACKET FOR EXPOSED PIPING IN
- DW-6 DOMESTIC WATER PIPING SHALL BE SLOPED FOR DRAINAGE WITH DRAIN VALVES INSTALLED AT LOW POINTS.
- SANITARY WASTE AND VENT PIPING (SS)
- SS-1 SANITARY WASTE PIPING BELOW GRADE: PROVIDE SERVICE WEIGHT CAST IRON HUB AND SPIGOT PIPE (ASTM A 74) WITH COMPRESSION JOINTS (CISPI HSN) AND NEOPRENE GASKETS (ASTM C 564) OR NO-HUB PIPE AND FITTINGS (CISPI 301) WITH NEOPRENE GASKET/STAINLES STEEL CLAMP JOINTS (CISPI 310) OR PROVIDE SCHEDULE 40 PVC PIPE AND SOCKET FITTINGS (ASTM D 2665) WITH SOLVENT WELD JOINTS (ASTM D2855). FOAM CORE PIPE IS NOT APPROVED.
- SS-2 SANITARY WASTE/VENT PIPING ABOVE GRADE: PROVIDE SERVICE WEIGHT CAST IRON NO-HUB PIPE AND FITTINGS (CISPI 301) WITH NEOPRENE GASKET AND STAINLESS STEEL CLAMP JOINTS (CISPI 310) OR PROVIDE SCHEDULE 40 PVC PIPE AND SOCKET FITTINGS (ASTM D 2665) WITH SOLVENT WELD JOINTS (ASTM D2855). FOAM CORE PIPE IS NOT APPROVED.
- SS-3 SLOPE SANITARY WASTE PIPING AT 1/4" PER FOOT MINIMUM FOR PIPING 2 1/2" OR SMALLER AND 1/8" PER FOOT MINIMUM FOR PIPING 3"AND LARGER UNLESS PERMITTED OTHERWISE.
- SS-4 PROVIDE CLEAN-OUTS AT EVERY TURN IN PIPING IN EXCESS OF 45 AND NO FURTHER THAN 100'-0" APART IN A LOCATION THAT PERMITS ACCESS FOR SERVICE WITHOUT DAMAGE TO THE BUILDING OR FINISHED MATERIALS.
- SS-5 PROVIDE FLOOR CLEANOUTS WITH TOPS DESIGNED TO MATCH SPECIFIC FLOOR FINISHES SUCH AS CARPET,

TILE, ETC. YARD CLEANOUTS SHALL BE PROVIDED IN AN 18"x18"x6" CONCRETE PAD.

SS-6 WHERE WASTE PIPING IS EXPOSED IN REST ROOM AREAS, PROVIDE REMOVABLE P-TRAPS, MATCHING STOPS AND ESCUTCHEONS FOR ALL LAVATORIES.

		C	CONNEC	ECTIONS (IN.)				
SYMBOL	DESCRIPTION	w	V	CW	нพ	SPECIFICAT	TON	REMARKS
<u>P1</u>	WATER CLOSET, HET ADA COMPLIANT ELONGATED BOWL FLOOR MOUNTED FLUSH TANK, 1.28 GPF	4"	2"	1/2"	Andrew Market and Andrew Andre	FIXTURE: AMERICAN STD. 211AA.1 SEAT: CHURCH 9500CT STOP: McGUIRE 185—LK MATERIAL: VITREOUS CHINA COLOR: WHITE	SEAT HEIGHT 17"-19" PROVIDE LEVER ON WIDE SIDE OF STALL.	
<u>P2</u>	LAVATORY ADA. COMPLIANT 20"X18" WLL MOUNTED 0.5 GPM FAUCET	2"	12"	1/2"	1/2"	FIXTURE: AMERICAN STD. 0355.0 GRID DRAIN: McGUIRE 155A GRI FAUCET: MOEN 8210F05 (LEVER P-TRAP: McGUIRE 8902 1‡" X STOPS: McGUIRE 175-LK	SEE NOTE 1 BELOW SEE ARCHITECTURAL PLANS FOR MOUNTING HEIGHT. PROVIDE 0.5 GPM AERATOR	
<u>P3</u>	S.S. UTILITY SINK FREE STANDING (24"X24" BOWL) WALL MOUNTED SERVICE FAUCET	1 1/2"	12"	1/2"	1/2"	FIXTURE: JUST F-127 DRAIN: JUST J-35-SF FAUCET: JUST JVB-1200 P-TRAP: McGUIRE 8912 1½"X1½" STOPS: McGUIRE 175		
<u>HB1</u>	HOSE BIBB, EXPOSED FROST PROOF, AUTOMATIC DRAINING ANTI-SIPHON VACUUM BREAKER, KEYLESS)	<u>-</u>	3/4"	-	EQUIPMENT: WOODFORD 65EP		EXTERIOR: MOUNT 18" AFF.
<u>FCO</u>	FLOOR CLEANOUT CAST IRON BODY ADJUSTABLE TOP	4"	-		_	CLEANOUT: JAY R. SMITH 4020 OUTLET: NO—HUB PLUG: ABS, IRON OR BRONZED COVER: ROUND, NICKEL BRONZE	WITH GASKET SEAL	
YCO	YARD CLEANOUT ADJUSTABLE, CST IRON BODY, COATED CAST IRON TOP	4"		-		CLEANOUT: JAY R. SMITH 4050 : OUTLET: NO—HUB PLUG: ABS, GASKET SEAL COVER: CAST IRON, HEAVY DUTY	SET IN CONCRETE PAD 18"W X 18"L X 6" THICK	
FD1	FLOOR DRAIN CAST IRON BODY ADJUSTABLE TOP	2"	_	_		DRAIN: ZURN INDUSTRIES STRAINER: 5" DIA, TYPE – , NIC P—TRAP: DEEP SEAL (MATCH DR		
<u>SA</u>	SHOCK ARRESTOR	-	-	1/2"	_	SIOUX CHIEF 650 SERIES WATTS	PPP, INC	PDI WH201 STANDARD DESIGNATION 'A" INSTALL PER PDI WH201 GUIDELINES
<u>WH1</u>	GAS FIRED TANKLESS WATER HEATER	_	_	1"	1"	NORITZ MODEL WC1991-OD-LP FLUE SIZE: PER MFG GAS INLET PRESSURE: 8" WC BTU/HR INPUT: 199000 FLOW RATE AT 80 F RISE: 4.6		EQUIV MFG: RINNAI, TAKAXX ELEC RMTS: 120v 15 AMP BREAKER
<u>P-4</u>	EYE WASH (FAUCET MOUNT)	-	-	_	_	ITEM# 8UKU0 MFR. MODEL# OK II LAB UNSPSC# 46181810		
<u>P-5</u>	DIAPHRAGM TANK	_	-	_	-	UTILITECH 52-GALLON VERTICAL 50 PSI RATED	PRESSURE TANK,	
TD1	TRENCH DRAIN PRE-CAST POLYESTER CONCRETE DUCTILE IRON GRATE 6" WIDECHANNEL SECTIONS	_		_	-	DRAIN: SMITH 9820 GRATE: SMITH 8970-465D-MS		EXTRA HEAVY DUTY GRATE (TRAFFIC RATED)
	NOTES: 1. PROVIDE PRE-MANUFACTURED IN 2. PROVIDE SURESEAL INLINE FLOO						MER.	
V D.D.	POVED FOLIALS		SPI	ECIFIED	PRODUC	T:	ACCEPTED EQUAL	:
THE PRO CLO	1. PROVIDE PRE-MANUFACTURED IN		SPI AM MO	EALER IN	PRODUC STANDAR	T: RD (VITREOUS CHINA FIXTURES)	ACCEPTED EQUAL KOHLER, ELJER,	TOPO AMERICAN STANDARD

McGUIRE (SUPPLY STOPS)

JAY R. SMITH (DRAINS, CLEANOUTS)


THE MANUFACTURER'S LISTED.

BRASSCRAFT, E.B.C.

ZURN, WADE

DESCRIPTION COLD WATER PIPING HOT WATER PIPING SANITARY WASTE PIPING SANITARY VENT PIPING GAS PIPING ELBOW DOWN ELBOW UP PIPE CAP GATE VALVE CHECK VALVE DIRECTION OF FLOW REDUCER FCO FLOOR CLEAN OUT YARD CLEAN OUT FLOOR DRAIN HOSE BIBB/WALL HYDRANT

SHOCK ARRESTOR

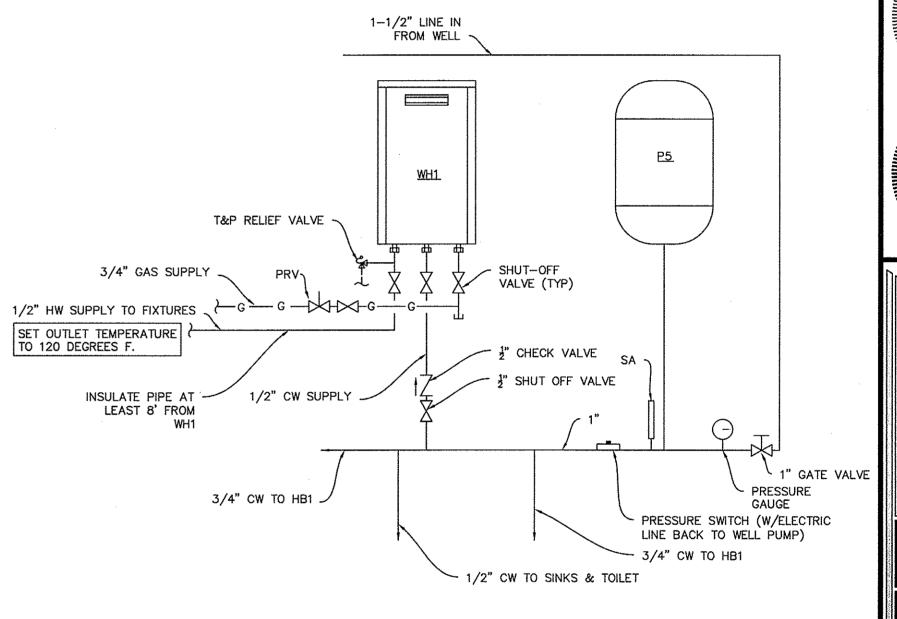

WATER HEATER SCHEMATIC NO SCALE



ALIGNED


ENGINEERING


No. 5025


STATION


PLUMBING NOTES

DESIG Jul 21, 2010 AE05

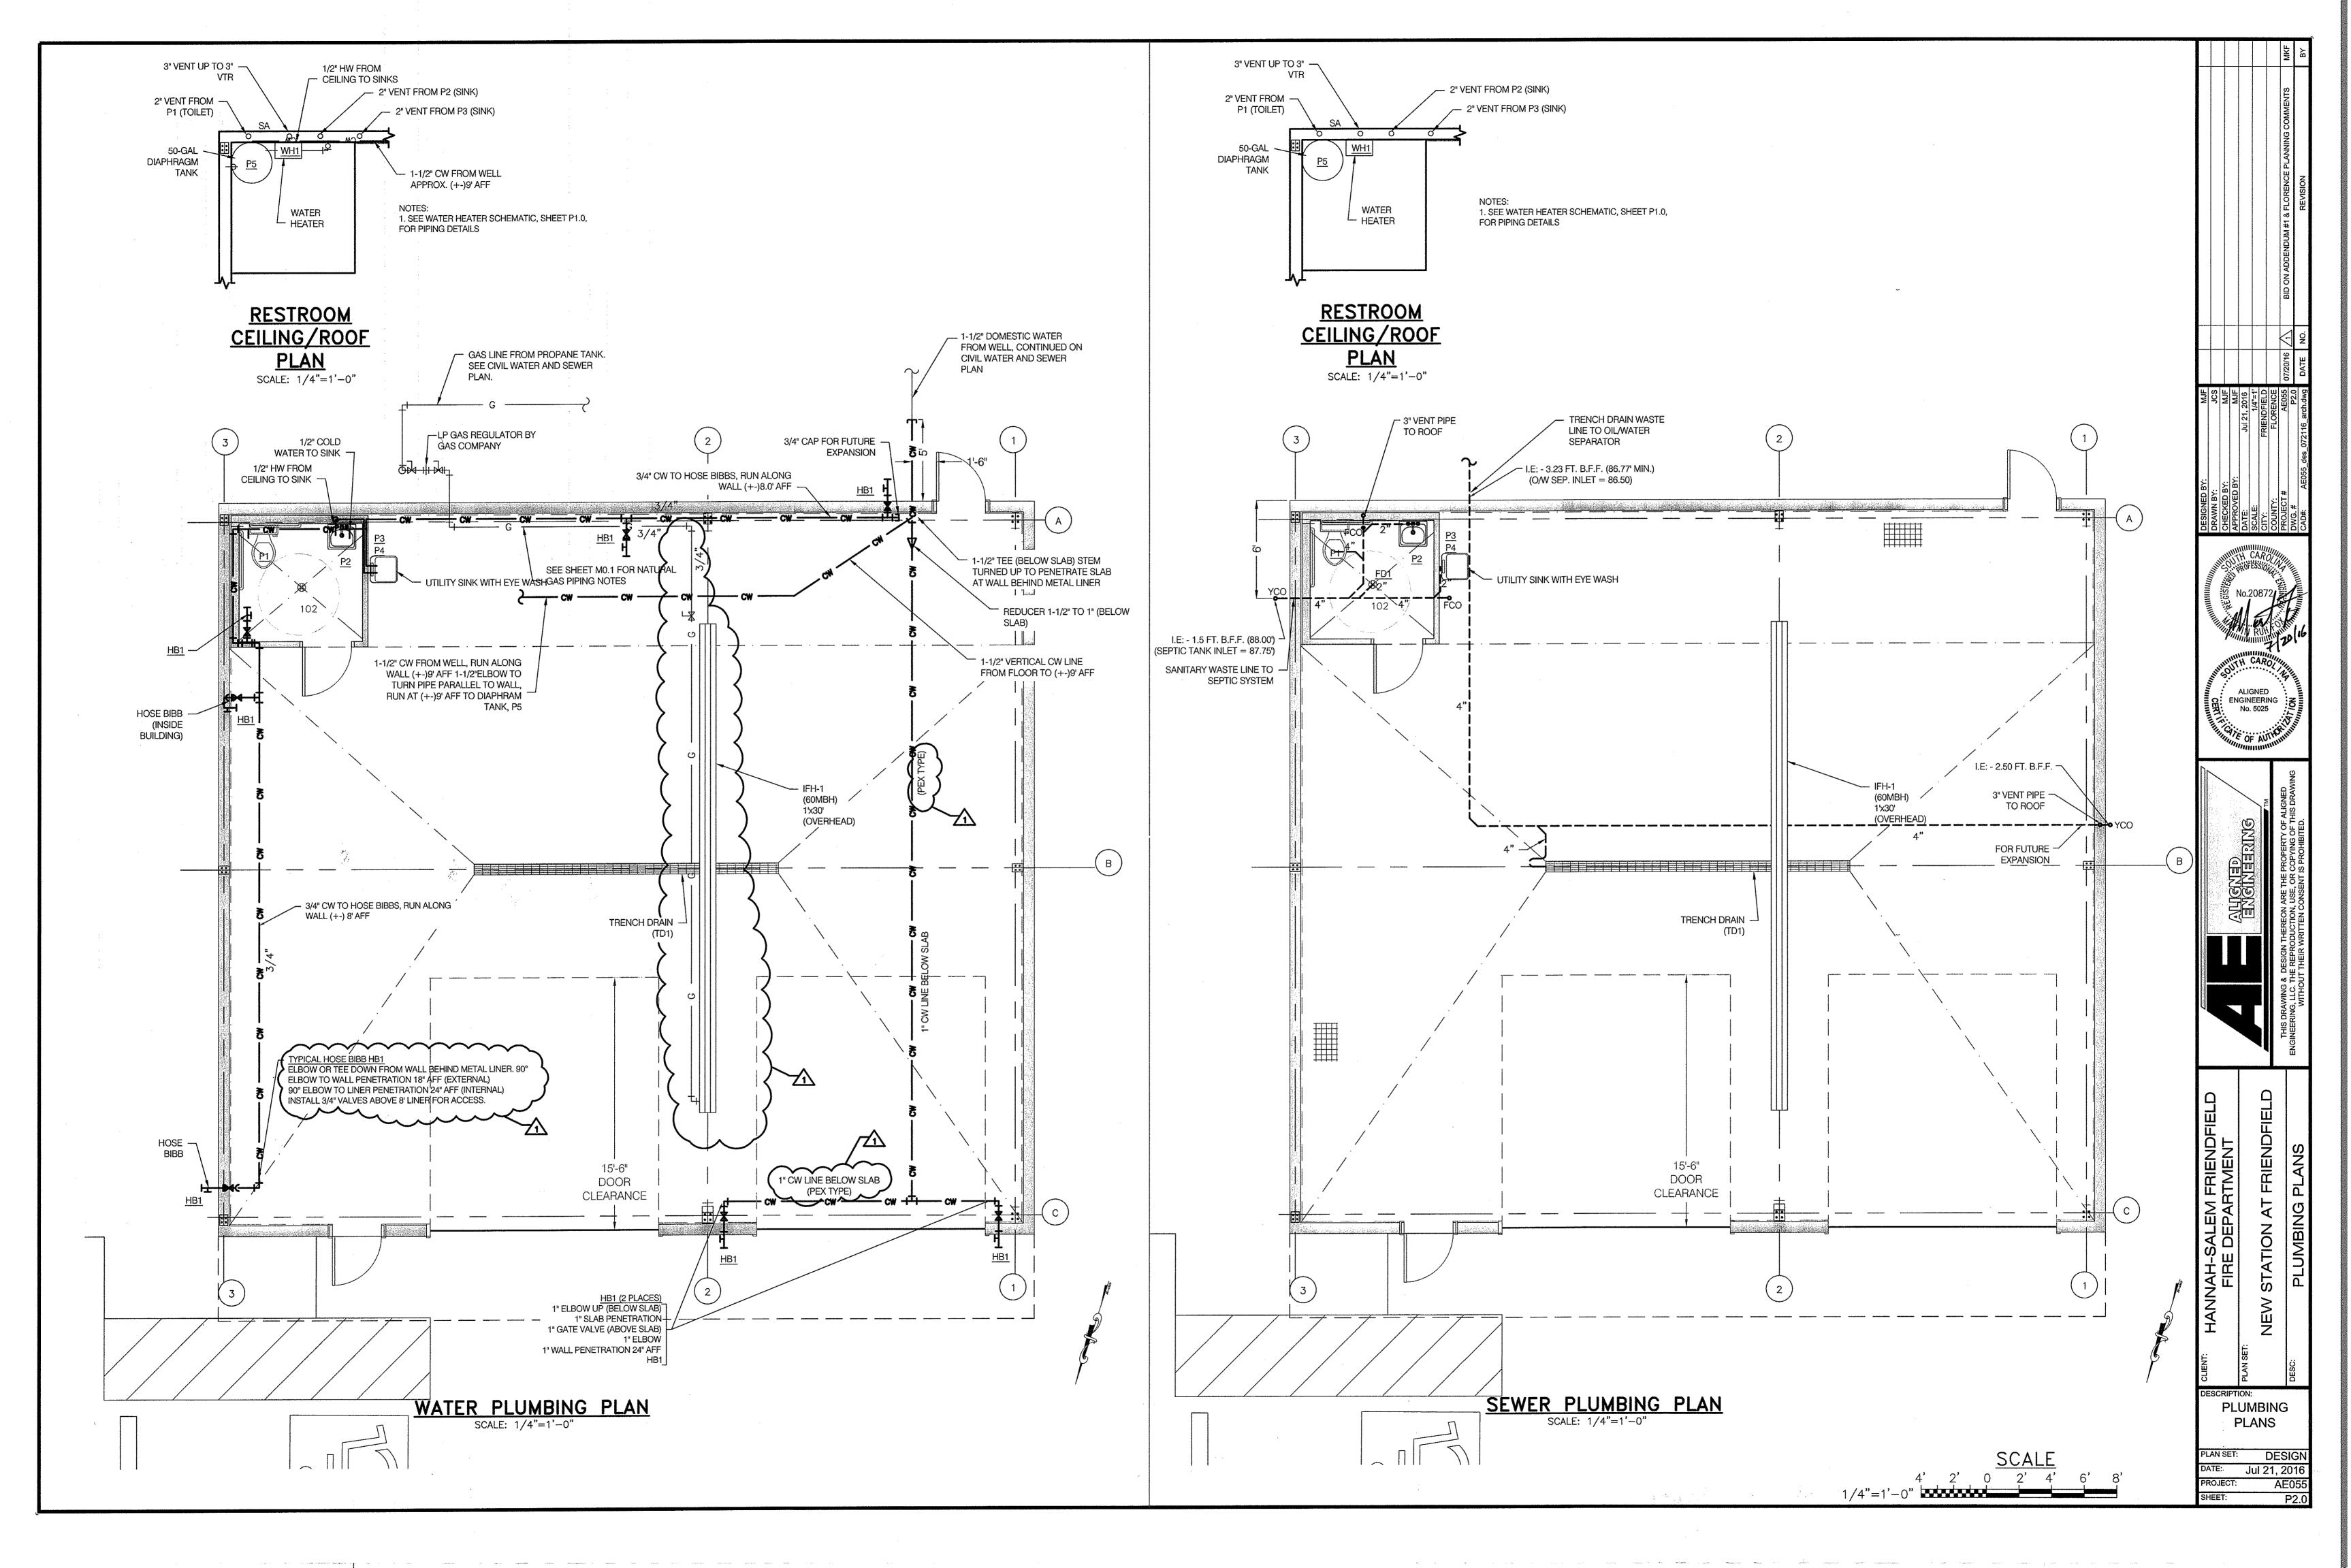


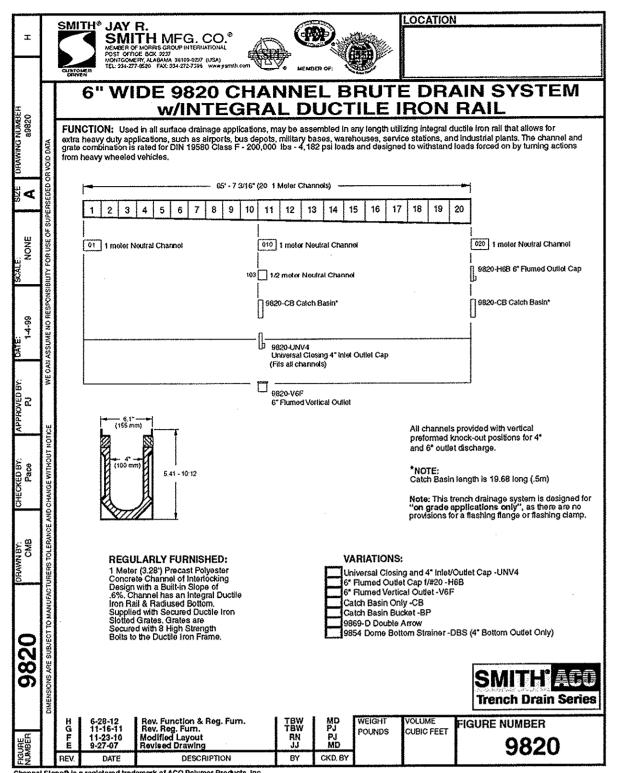

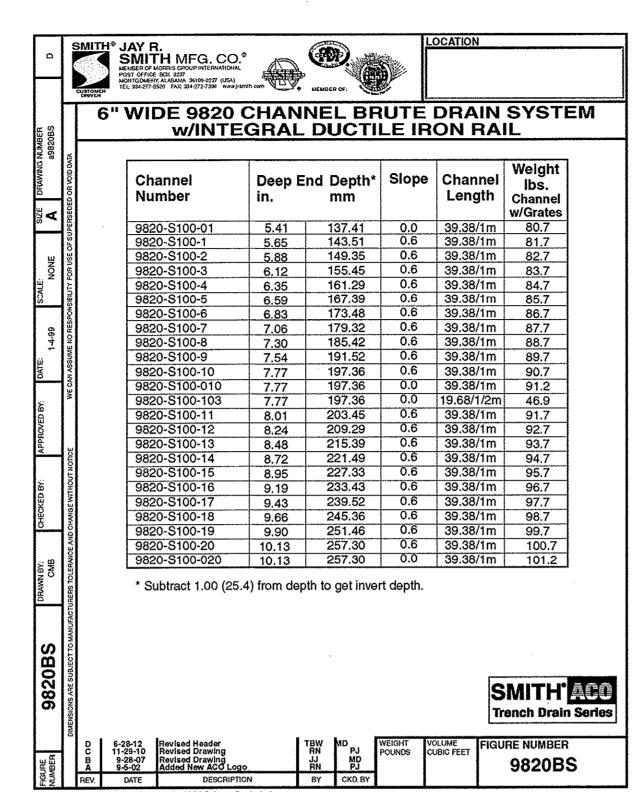

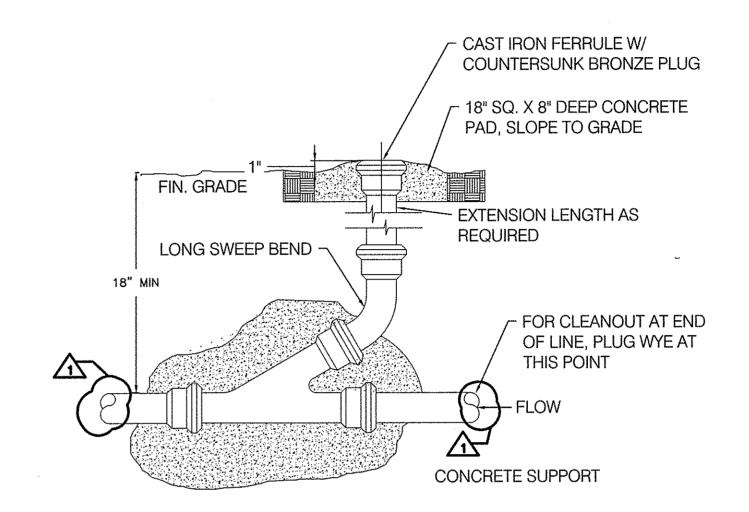



GRADE CLEANOUT DETAIL
N.T.S.

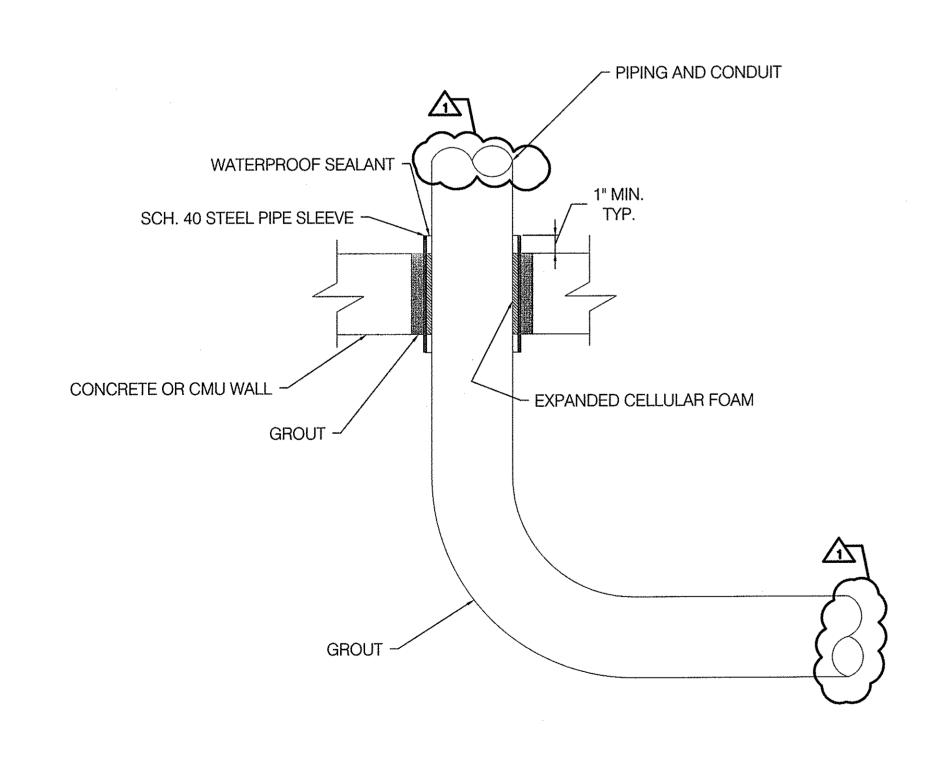

CONDUIT SLEEVE DETAIL

THRU CONCRETE FLOORS

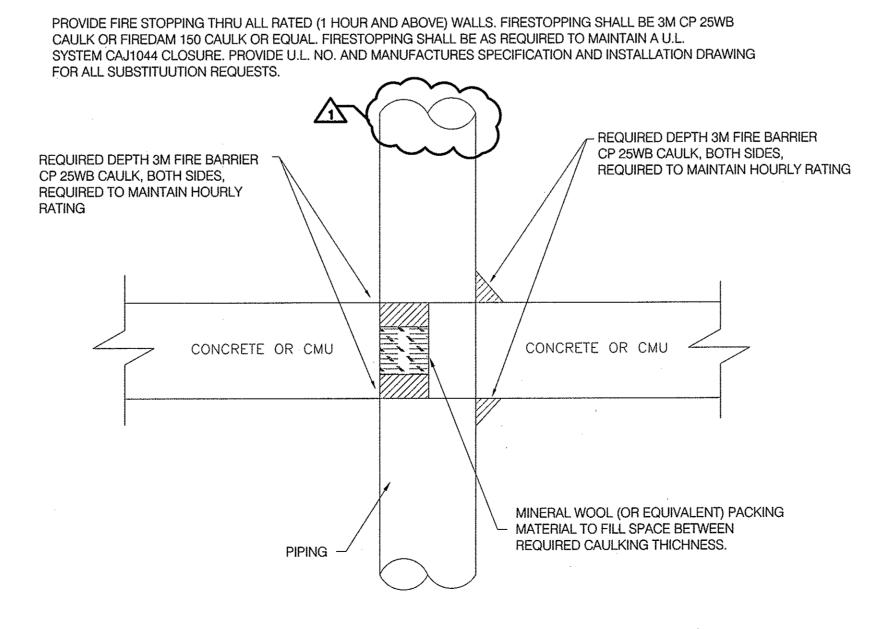

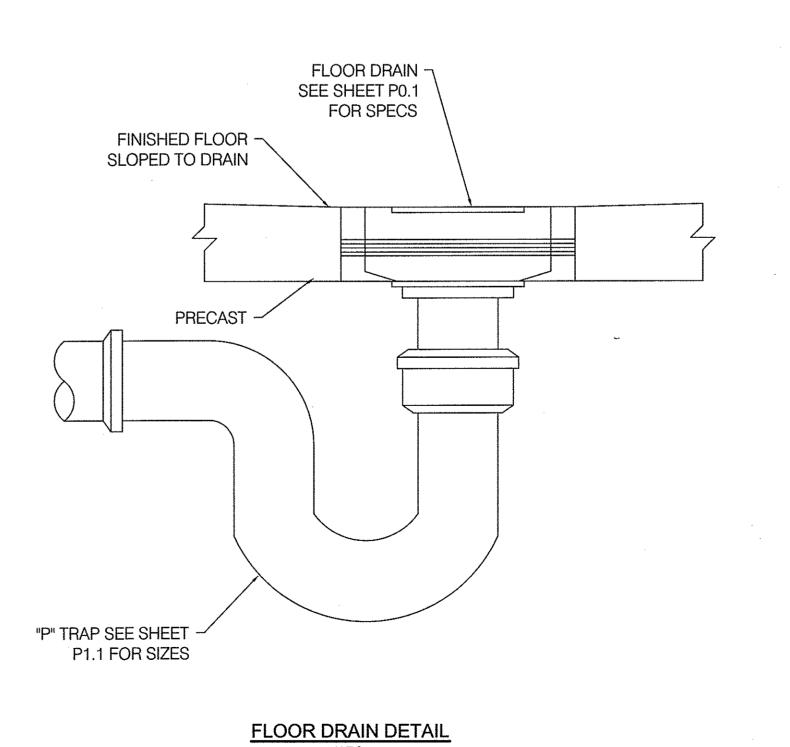

TYPICAL PIPING SLEEVE DETAIL

N.T.S.

PLUMBING
DETAILS

PLAN SET: DESIGN
DATE: Jul 21, 2016
PROJECT: AE055

ALIGNED ENGINEERING

No. 5025